

Section 33 Township 9 Range 20 W

Well No. # 2 Bruggeman

Company Virginia Drlg.

**NORTH**

	○						

**WEST**

**EAST**

**SOUTH**

Rooks

KANSAS

Sec. 33 Twp. 9 R. 20W

Well No. #2 Bruggeman Farm

Virginia Drlg. Company

Virginia Drlg. Contractor

Virginia Hampton Pool


330 Ft. from N. Line

\_\_\_\_\_ Ft. from S. Line

\_\_\_\_\_ Ft. from E. Line

990 Ft. from W. Line

NE NW NW

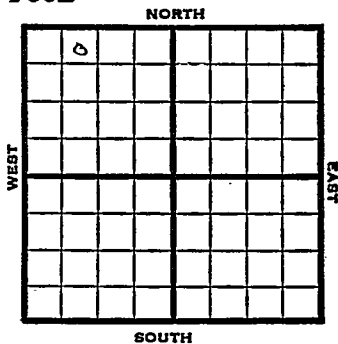

1951 Elev. 2287' REPORT

10/3 RUR

10/31 Spud 10-11-51  
 D&A TD 3914  
 8" @ 160  
 Anhy 1791 Top. 3341  
 Heeb. 3553 Lans. 3591  
 Cong. 3864 Ch. Cong. 3901  
 TD 3914'  
 D&A

**ABANDONED**

County Rooks State Kansas

Sec. 33 (Blk. Twp.) 9 (Sur. Rge.) 2 OW Map No.

Operator Virginia Drlg.

Well No. 2 Farm Bruggeman

Elev. \_\_\_\_\_ Location NE NWNW

o					
<b>FIRST REPORT</b>					

330 Ft. From N Line NW

990 Ft. From W Line Quarter

Ist. Report OCT 3 1951

Completion \_\_\_\_\_

Remarks \_\_\_\_\_

Virginia Drlg. - Contr.

Spudding Date \_\_\_\_\_

Drlg. Data Hampton Pool

R U R

County \_\_\_\_\_ Rocks \_\_\_\_\_ State Kansas

Sec. 33 (Blk. Twp.) 9 (Sur. Rge.) 20W Map No. \_\_\_\_\_

Operator Virginia Drlg.

Well No. 2 Farm Bruggeman

Elev. 2287 Location NE NW NW

0					

330 Ft. From N Line NW

990 Ft. From W Line Quarter

Ist. Report OCT 31 1951

Completion \_\_\_\_\_

Remarks Hampton Pool

Virginia Drlg. - Contr.

Spudding Date 10-11-51

Drlg. Data D & A TD 3914

8" @ 160 Anhy 1791 Top. 3341

Heeb. 3553 Lans. 3591 Cong. 3864

Ch. Cong. 3901 TD 3914

D & A

J. E. TYRA