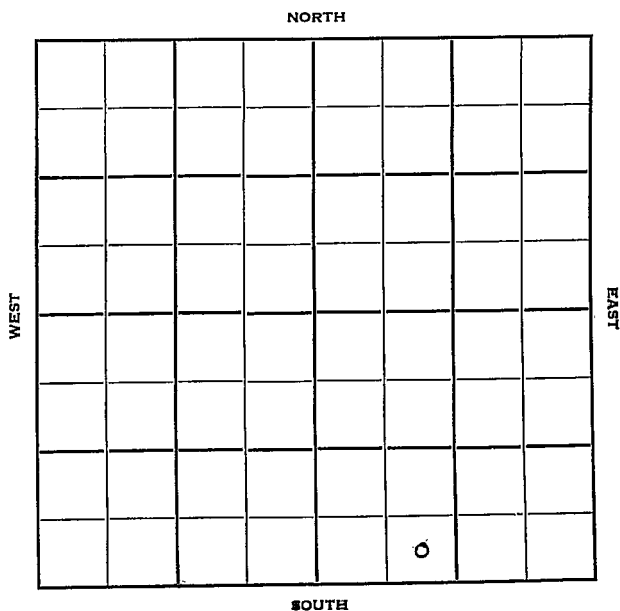


Section 33 Township 9 Range 20-WWell No. #3 Marcotte "B"Company Lohman & Johnson

Rooks

KANSAS

Sec. 33 Twp. 9 R. 20W

Well No. #3 Marcotte "B" Farm

Lohman & Johnson Company

Contractor

Marcotte Pool

Ft. from N. Line

330'

Ft. from S. Line


Ft. from E. Line

990'

Ft. from W. Line

SE SW SE

Oil Well

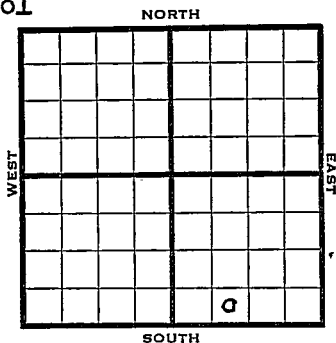

1950

Elev. 2265' REPORT

7/5

Spud 6-29-50

8" @ 370'

Anhy 1754'

Drlg. 2575'

9/13

8" @ 370

Anhy 1754

Dodge 3524

Simp 3833

5" @ 3851

FU 700' oil 2 hr

1200' oil 100' wtr 12 hr S/7 boph

PB 3850

Comp 90 bo 30 bwpd

TD 3852

Completed

COMPLETED


Heeb 3502

Lans 3542

Arb 3850-52

Map No. _____ Sec. 33 Twp. 9 R. 20WWell No. 3 Marcotte "B"_____
Lohman & Johnson Company_____
Contractor

SE SW SE

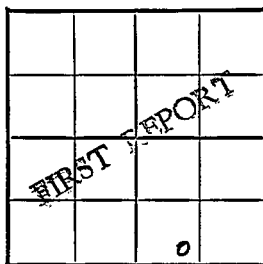E1-2265
SECTION PLAT_____
Ft. from N. Line330 Ft. from S. Line_____
Ft. from E. Line990 Ft. from W. LineRooks County

Location _____

Rig up _____

Drilling and Remarks:

Spud 6-29-50

8" C 370

Anhy 1754

drlg. 2575

RECORD

Cased _____ in., _____ ft.

Sand _____

Gas _____

Oil _____

Total Depth _____

PRODUCTION

1st 24 hrs. Nat. _____

1st 24 hrs. after shot _____


Gas _____ Cu. Ft.

Dry Hole _____

Abandoned _____

Date

JUL 5 1950 19J. E. TYRA Scout

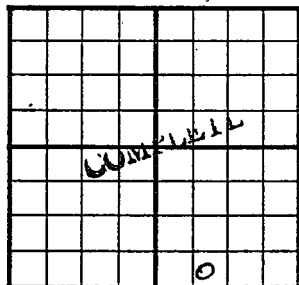County _____ Rooks _____ State KansasSec. 33 (Blk. Twp.) 9 (Sur. Rge.) 20W Map No. _____Operator Lohman & JohnsonWell No. 3 Farm Marcotte "B"Elev. 2265 Location SE SW SE330 Ft. From S Line SE990 Ft. From W Line Quarter

1st. Report _____

Completion SEP 13 1950

Remarks _____

Marcotte PoolSpudding Date 6-29-50Drlg. Data Oil well TD 38528" @ 370 Anhy 1754 Heeb. 3502Dodge 3524 Lans. 3542 Simp. 3833Arb. 3850-52 5" @ 3851 FTL 700' oil 2 hr.1200' oil 100' water 12 hr. S/ 7 bophPB 3850 Comp. 90 bo 30 bwpd

J. E. TYRA