


KANSAS

Rooks

Section 33 Township 9 Range 20

Well No. #1 E Marcotte

Company Continental

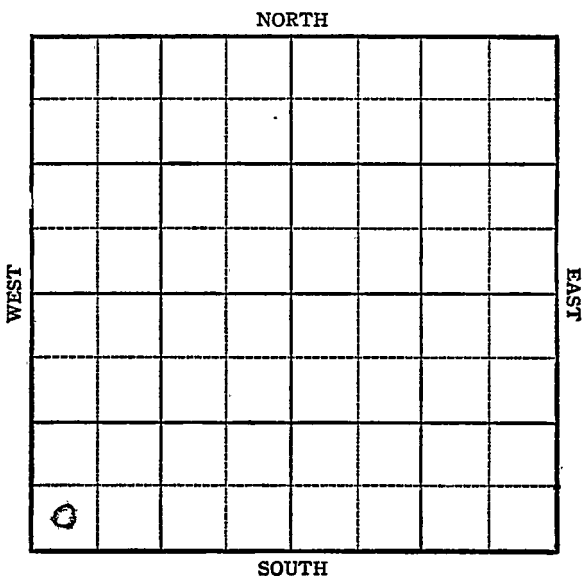

Rooks

Sec. KANSAS Twp. 9 R. 20W

Well No. #1 E Marcotte Farm

Continental Company

Palco

NORTH

 Ft. from N. Line

330 Ft. from S. Line

 Ft. from E. Line

330 Ft. from W. Line

WEST

EAST

SOUTH

Elev. 2258

1944

REPORT

7/26 Location

8/2 10" @ 241 WOC

8/9 Drlg. 3050

8/16 Arb. 3839-44TD

8/23 6" @ 3840 MUST

8/30 2800¹ oil in 6 hrs.

9/8 Swb 85 oil per hr 2 $\frac{1}{2}$ hrs.

9/13 " " " " " "

9/21 " " " " " "

9/28 " " " " " "

10/4 " " " " " "

10/11 " " " " " "

10/18 " " " " " "

10/25 " " " " " "

11/2 " " " " " "

11/8 " " " " " "

11/16 " " " " " "

11/24 " " " " " "

11/29 " " " " " "

12/6 " " " " " "

12/14 " " " " " "

12/21 " " " " " "

12/29 " " " " " "

1945

1/3 " " " " " "

1/10 " " " " " "

1/17 " " " " " "

OVER

1945

1/26 Swb. 85 oil per hr. $2\frac{1}{2}$ hrs.

1/31 Arb. 3839
6" @ 3840
TD 3844
Depth Pot 11000
Max. 3000
Grav. 27.4

COMPLETED

KANSAS Pool Name Palco
 Map No. 65 Sec. 33 Twp. 9 R. 20W

Well No. 1 E. Marcotte

Continental


Company

FIRST REPORT

Contractor

SW/C

SECTION PLAT

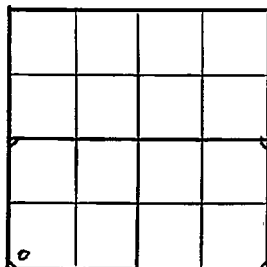

 Ft. from N. Line

330 Ft. from S. Line

 Ft. from E. Line

330 Ft. from W. Line

Rooks County

Location X

Rig up

Drilling and Remarks:

RECORD

Cased in., ft.

Sand

Gas

Oil

Total Depth

PRODUCTION

1st 24 hrs. Nat.

1st 24 hrs. after shot

Gas Cu. Ft.

Dry Hole

Abandoned

Date

JUL 26 1944

19

S. J. LEWIS

Scout

Pool Name Patco PoolMap No. 15-65 Sec. 33 Twp. 9 R. 20WWell No. 1 E. MarcotteContinental Company**COMPLETED**

Contractor

SW/c

SECTION PLAT

 Ft. from N. Line330 Ft. from S. Line Ft. from E. Line330 Ft. from W. LineBooksLocation Rig up

Drilling and Remarks:

See X 38396" C 3840Depth 11000Max 300027 1/2 Gr**RECORD**Cased in., ft.Sand Gas Oil Total Depth 3844**PRODUCTION**1st 24 hrs. Nat. 1st 24 hrs. after shot Gas Cu. Ft.Dry Hole Abandoned

Date

JAN 31 194519S. J. LEWISScout