



# Graham KANSAS


SEC. 33	TWP. 9	R. 21W
---------	--------	--------

WELL NO. **1 Bragg** FARM

COMPANY **Francis Oil & Gas**

CONTRACTOR **Veeder Supply**

**990** **N. Cooper Pool**  
 \_\_\_\_\_ Ft. from N. Line  
 \_\_\_\_\_ Ft. from S. Line  
 \_\_\_\_\_ Ft. from E. Line  
**336** \_\_\_\_\_ Ft. from W. Line

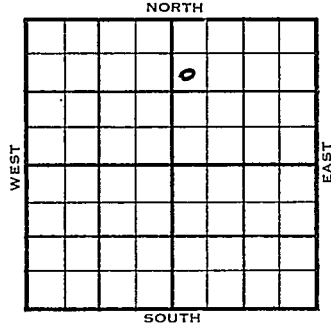

SW NW NE

1954	ELEVATION 2300'	REPORT
------	-----------------	--------

8/4 **Celler & Pits**

9/8 Spud 8-4-54 Oil well TD 3858  
 8" @ 190 Anhy 1760 Heeb 3482  
 Lans 3523 Cong 3815 Arb. 3851  
 TD 3856 5" @ 3853 DD 3858  
 S/180 BO 4 hr.  
 Comp. 3000 BOPD

**COMPLETED**



