
DX 78-1

Graham KANSAS

Section 33 Township 9 Range 21W

Well No. 3 Bragg

Company Francis C&G

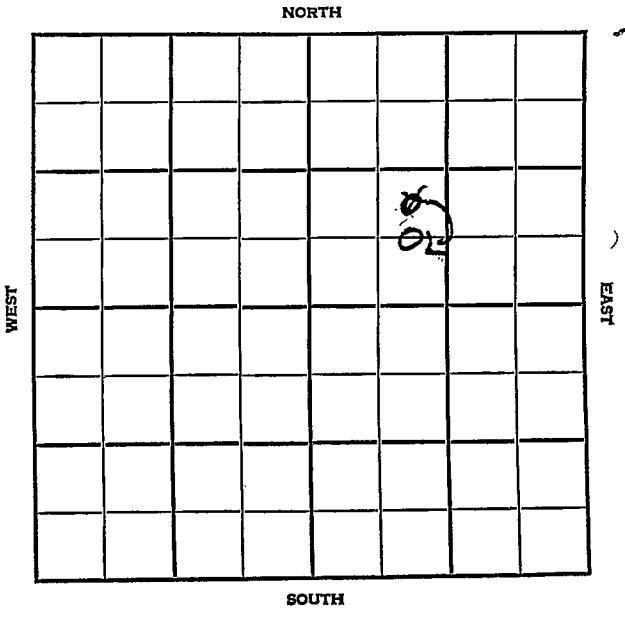

Graham KANSAS

SEC.	TWP.	R.
33	9	21W

WELL NO.

#3 Bragg FARM
COMPANY

Francis O & G
CONTRACTOR

Veeder Tools
No Cooper Pool

NORTH

_____ Ft. from N. Line

~~990~~ 660 Ft. from S. Line

_____ Ft. from E. Line

990 Ft. from W. Line

WEST

EAST

SOUTH

C E/2 ~~NE~~ SW NE

	ELEVATION	REPORT
1954	2305'	
9/29		Spud 9-22-54 8" @ 208' w/130 sks Anhy 1780' Drlg 3342'
11/23		Spud 9-22-54 Oil well TD 3858 8" @ 208 Anhy 1780 Heeb 3487 Tor. 3504 Arb. 3851 TD 3856 5" @ 3853 Lans 3528 CO to 3856 DD 3858 S/58 BO 3 hr. Comp. 3000 BOPD COMPLETED

DX-78

FORM 275. FOR SALE BY KANSAS BLUE PRINT CO.


County Graham State Kansas

Sec. 33 (Blk. Twp.) 9 (Sur. Rge.) 21W Map No.

Operator Francis Oil & Gas

Well No. 3 Farm Bragg

Elev. Location NE SW NE

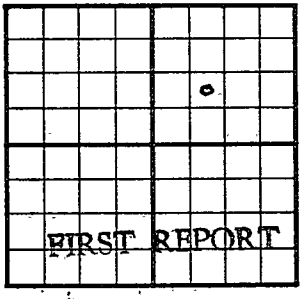

990 Ft. From S Line NE

990 Ft. From W Line Quarter

1st. Report SEP 2 9 1954

Completion

Remarks

Veeder Tools

Spudding Date 9/22/54

Drlg. Data No. Cooper Pool

8" @ 208 w/130 Anh 1780, Drlg 3342

FABEN GILSTRAP

FORM 26 200 BKS, 4-52 PETROL

Kansas

Map No. _____ Sec. 33 Twp. 9 R. 21W


Well No. 3 Bragg

Francis Oil & Gas
Company

CORRECTION
Contractor

C E½ SW NE

SECTION PLAT

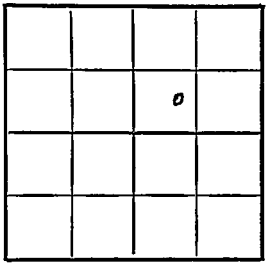

_____ Ft. from N. Line

660 Ft. from S. Line

_____ Ft. from E. Line

990 Ft. from W. Line

Graham County

Location _____

Rig up _____

Drilling and Remarks:

Reported
NE SW NE

RECORD

Cased _____ in., _____ ft.

Sand _____

Gas _____

Oil _____

Total Depth _____

PRODUCTION

1st 24 hrs. Nat. _____

1st 24 hrs. after shot _____

Gas _____ Cu. Ft.

Dry Hole _____

Abandoned _____

Date

OCT 6 1954

19

FABEN GILSTRAP
Scout

FORM 275 FOR SALE BY KANSAS BLUE PRINT CO.


County Graham State Kansas

Sec. 33 (Blk. Twp.) 9 (Sur. Rge.) 21W Map No.

Operator Francis Oil & Gas

Well No. 3 Farm Bragg

Elev. 2305 Location C E½ SW NE

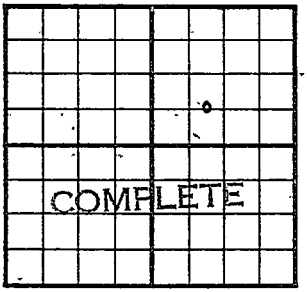

660 Ft. From S Line NE

990 Ft. From W Line Quarter

1st. Report

Completion NOV 23 1954

Remarks N. Cooper Pool
Veeder - Contr.

Spudding Date 9-22-54

Drlg. Data Oil well TD 3858

8" @ 208 Anhy 1780 Heeb. 3487

Tor. 3504 Arb. 3851 TD 3856 5" @ 3853

Lans. 3528 CO to 3856 DD 3858

S/ 58 bo 3 hr. Comp. 3000 bopd

FABER GILST