DX 78-1

Graham KANSAS

Section 33 Township 9 Range 21 W

Well No. # 2 Bragg

Company Francis Oil & Gas

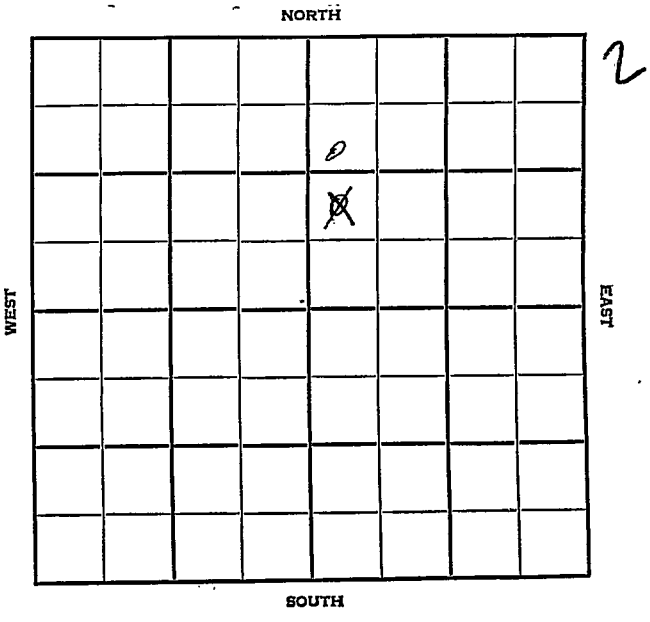

Graham KANSAS

SEC.	TWP.	R.
33	9	21W

WELL NO.

#2 Bragg FARM

COMPANY

Francis O & G

CONTRACTOR

Veeder Tools

Cooper No. Pool

1250 Ft. from N. Line

~~990~~ Ft. from S. Line

Ft. from E. Line

600
~~330~~ Ft. from W. Line

SW NW NE
~~NW SW NE~~

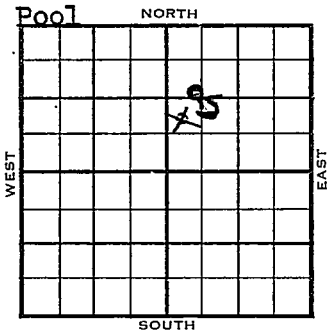

	ELEVATION	REPORT
1954	2304'	
9/15	Spud 9-10-54 8" @ 198' Anhy 1784' Drlg. 2480'	
12/15	Spud 9-10-54 Oil Well TD 3863' 8" @ 198' Anhy 1784', Heeb 3488' Tor 3506', Lans 3528' B KC 3753' Cong 3823' Arb. 3856' TD 3859' 5" @ 3858' CO to 3859' S/ 20 boph 4 hr. DD 3863' S/ 30 boph 4 hr. Comp 2500 bopd.	COMPLETED

DX-78

FORM 275 FOR SALE BY KANSAS BLUE PRINT CO.

County Graham State Kansas

Sec. 33 (Blk. Twp.) 9 (Sur. Rge.) 21W Map No.

Operator Francis Oil & Gas

Well No. 2 Farm Bragg

Elev. Location NW SW NE

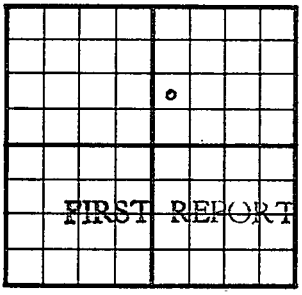

990 Ft. From S Line NE

330 Ft. From W Line Quarter

1st. Report SEP 15 1954

Completion

Remarks Veeder Tools

Spudding Date 9/10/54

Drlg. Data Cooper No. Pool

8" @ 198 Anhy 1784 Drlg 2480

FABEN GILSTRAP

FORM 26 200 BKS, 4-52 PETROL

Kansas

Map No. _____ Sec. 33 Twp. 9 R. 21W

Well No. 2 Bragg

Francis Oil & Gas Company

CORRECTION Contractor

SW NW NE

SECTION PLAT

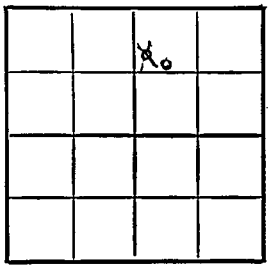

1250 Ft. from N. Line

_____ Ft. from S. Line

_____ Ft. from E. Line

600 Ft. from W. Line

Graham County

Location _____

Rig up _____

Drilling and Remarks:

Reported
NW SW NE

RECORD

Cased _____ in., _____ ft.

Sand _____

Gas _____

Oil _____

Total Depth _____

PRODUCTION

1st 24 hrs. Nat. _____

1st 24 hrs. after shot _____

Gas _____ Cu. Ft.

Dry Hole _____

Abandoned _____

Date

OCT 6 1954 19

FABEN GILSTRAP Scout

FORM 275 FOR SALE BY KANSAS BLUE PRINT CO.

County Graham State Kansas

Sec. 33 (Blk. Twp.) 9 (Sur. Rge.) 21W Map No.

Operator Francis Oil & Gas

Well No. 2 Farm Bragg

Elev. 2304 Location SW NW NE

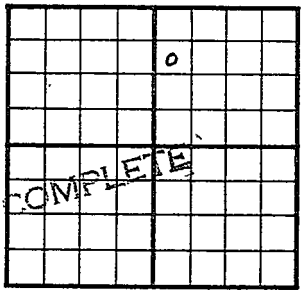

1250 Ft. From N Line NE

600 Ft. From W Line Quarter

1st. Report

Completion DEC 15 1954

Remarks N. Cooper Pool
Veeder - Contr.

Spudding Date 9-10-54

Drlg. Data Oil well TD 3863

8" @ 198 Anhy 1784 Heeb. 3488

Tor. 3506 Lans. 3528 B KC 3753

Cong. 3823 Arb. 3856 TD 3859

5" @ 3858 CO to 3859 S/ 20 boph 4 hr.

DD 3863 S/ 30 boph 4 hr.

Comp. 2500 bopd

FABEN GILSTRA