


DX 78-1

Graham KANSAS

Section 33 Township 9 Range 21W

Well No. 4 Bragg

Company Francis O&G

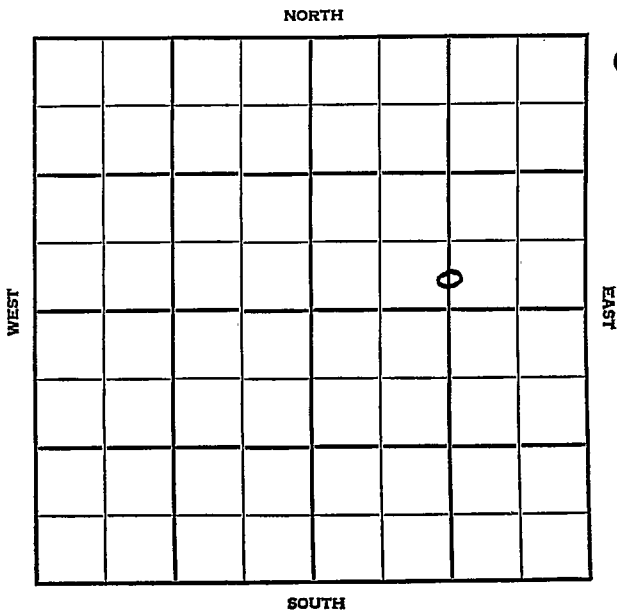

Graham KANSAS

SEC.	TWP.	R.
33	9	21 W

WELL NO. π 4 Bragg FARM

COMPANY Francis Oil & Gas

CONTRACTOR Ferrell


N. Cooper Pool

_____ Ft. from N. Line

330 Ft. from S. Line

1190 Ft. from E. Line

_____ Ft. from W. Line

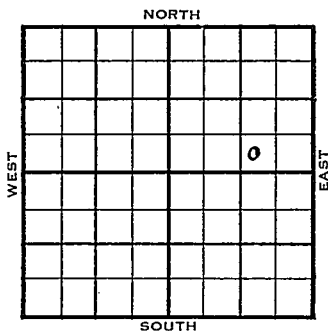

C S $\frac{1}{2}$ S $\frac{1}{2}$ NE

.. "

1954	ELEVATION 2310'	REPORT
------	---------------------------	--------

10/13 Spud 10-8-54
8" @ 220
Drlg. 1975'

12/8 Spud 10-8-54
Oil Well
TD 3877'
8" @ 220' -
Tor. 3521', Lans 3545' Cong 3835'
Arb. 3871'
TD 3877'
5" @ 3871'
CO to 3877' FU 2500' oil 1 hr.
40 min. test 37 $\frac{1}{2}$ boph 4 hr.
Comp 3000 bopd.

COMPLETED

