Graham


FORM 51 IOM 12-46 PETROL

KANSAS

Section 33 Township 9 Range 21W

Well No. 1 Cox

Company Derby et al

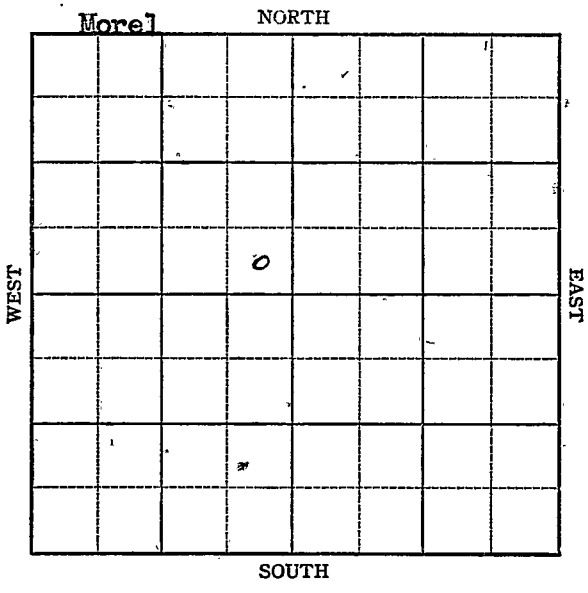

FORM 252-A
5M 12-46 PETROL

KANSAS

Graham ✓

Sec. 33 Twp. 9 R. 21W

Well No. 1 Cox Farm

Derby etal Company

Morel


____ Ft. from N. Line

330 Ft. from S. Line

330 Ft. from E. Line

____ Ft. from W. Line

SE NW

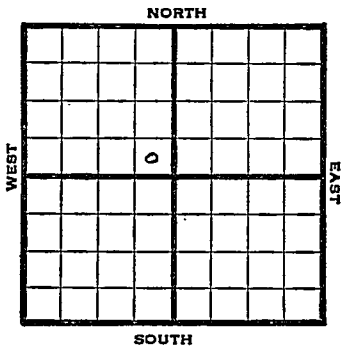

	REPORT
1947	Elev. 2302'
4/30	Location
5/7	8" @ 326 Lans 3498 Drlg 3870'
5/14	Arb. 3884' TD 4018'

3884
2302
-1582

ABANDONED

Form 26 200 Bks. 10-46 Petrol

Kansas

Morel Pool

Map No. 65 Sec. 33 Twp. 9 R. 21W


Well No. 1 Cox

Derby etal.
Company

FIRST REPORT
Contractor

SE NW

SECTION PLAT

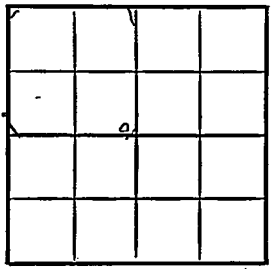

____ Ft. from N. Line

330 Ft. from S. Line

330 Ft. from E. Line

____ Ft. from W. Line

Graham County

Location x

Rig up

Drilling and Remarks:

RECORD

Cased ____ in., ____ ft.

Sand

Gas

Oil

Total Depth

PRODUCTION

1st 24 hrs. Nat.

1st 24 hrs. after shot

Gas ____ Cu. Ft.

Dry Hole

Abandoned

Date

APR 30 1947 19

S. J. LEWIS Scout

Form 26 200 Bks. 10-46 Petrol

Kansas Morel Pool

Map No. K65 Sec. 33 Twp. 9 R. 21W

Well No. 1 Cox


Derby etal. Company

ABANDONED Contractor

SE NW

E 12302

SECTION PLAT

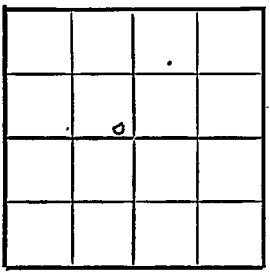

Ft. from N. Line

330 Ft. from S. Line

330 Ft. from E. Line

Ft. from W. Line

Graham County

Location

Rig up

Drilling and Remarks:

Cr #3884

RECORD

Cased in., ft.

Sand

Gas

Oil

Total Depth 4015

PRODUCTION

1st 24 hrs. Nat.

1st 24 hrs. after shot

Gas Cu. Ft.

Dry Hole

Abandoned

Date

MAY 14 1947 19

S. J. LEWIS Scout