


Graham

Section 33 Township 9 Range 21W

Well No. 1 Frazier

Company Jones, Shelburne & Farmer

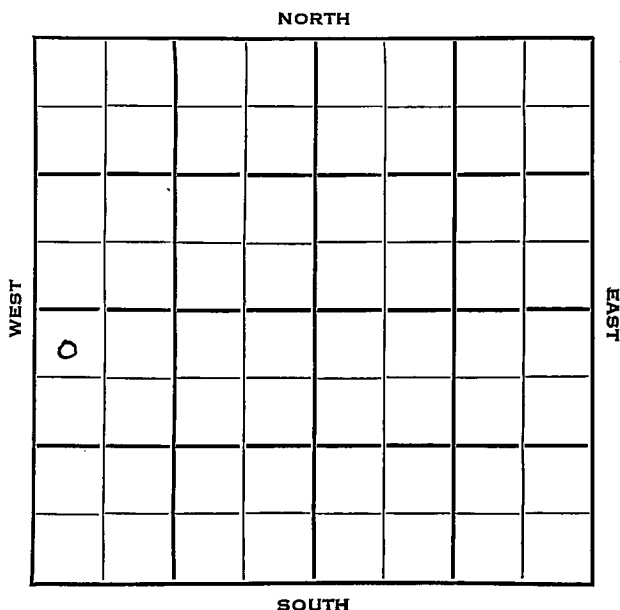

Graham

KANSAS


Sec. 33 Twp. 9 R. 21 WWell No. # 1 Frazier FarmJones, Shelburne & Farmer CompanyJ-S-F Contractor330 Ft. from N. Line

Ft. from S. Line

Ft. from E. Line

330 Ft. from W. Line

NW NW SW

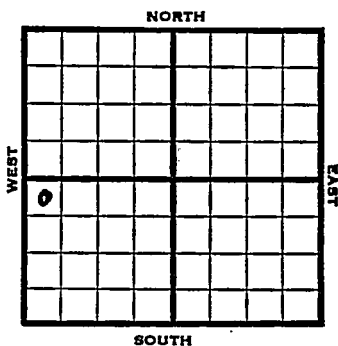

1952 Elev. 2336' REPORT

12/17 MIR

12/18 MIR

12/25 MIR

1/1 Heeb 3523, Lasn 3562, Drlg 3695
 1/8 BKC 3778 Cong. 3863 Arb 3904 DST 3905-
 14 RTD 1/2 Hr. 1980' Oil 1110# 5"
 @ 3905 CO

1/15 ~~XXXXX~~
 CO 3914
 S/30 BOPH

1/22 NR

1/29 "

2/4 Spud 12-16-52 Oil well TD 3914'
 8" @ 760 Anhy 1810' Heeb 3523'
 Lans. 3562' B KC 3778' Cong 3863'
 Arb. 3904'
 DST 3905-14 open $\frac{1}{2}$ hr. rec 1980' oil
 1110# 5" @ 3905 CO to 3914
 S/30 BOPH
 Comp. 391 BOPD

COMPLETED

County **Graham** State **Kansas**

Sec. **33** (Blk. Twp.) **9** (Sur. Rge.) **21W** Map No.

Operator **Jones, Shelburne & Farmer**

Well No. **1** Farm **Frazier**

Elev.	Location	NW	NE	SW
-------	----------	----	----	----

0

FIRST REPORT

330 Ft. From N Line SW

330 Ft. From W Line Quarter

1st. Report DEC 17 1952

Completion

Remarks

J-S-F- Contr.

Spudding Date

Drlg. Data

M I R

J. G. McGUIRE

County Graham State Kansas
 Sec. 33 (Blk.) 9 (Sur.) 21W Map No.
 Operator Jones, Shelburne & Farmer
 Well No. 1 Farm Frazier
 Elev. 2336 Location NW NW SW

330 Ft. From N Line SW
330 Ft. From W Line Quarter

1st. Report

Completion FEB 4 1953

Remarks

J-S-F - Contr.

Spudding Date 12-16-52

Drlg. Data Oil well TD 3914
8" @ 760 Anhy 1810 Heeb. 3523
Lans. 3562 B KC 3778 Cong. 3863
Arb. 3904 DST 3905-14 open $\frac{1}{2}$ hr.
Rec. 1980' oil 1110# 5" @ 3905
GO to 3914 S/ 30 bopd Comp. 391 bopd

J. G. McGEHEE