


Section 33 Township 9 Range 21 W

Well No. # 2 Frazier

Company Jones, Shelburne & Farmer

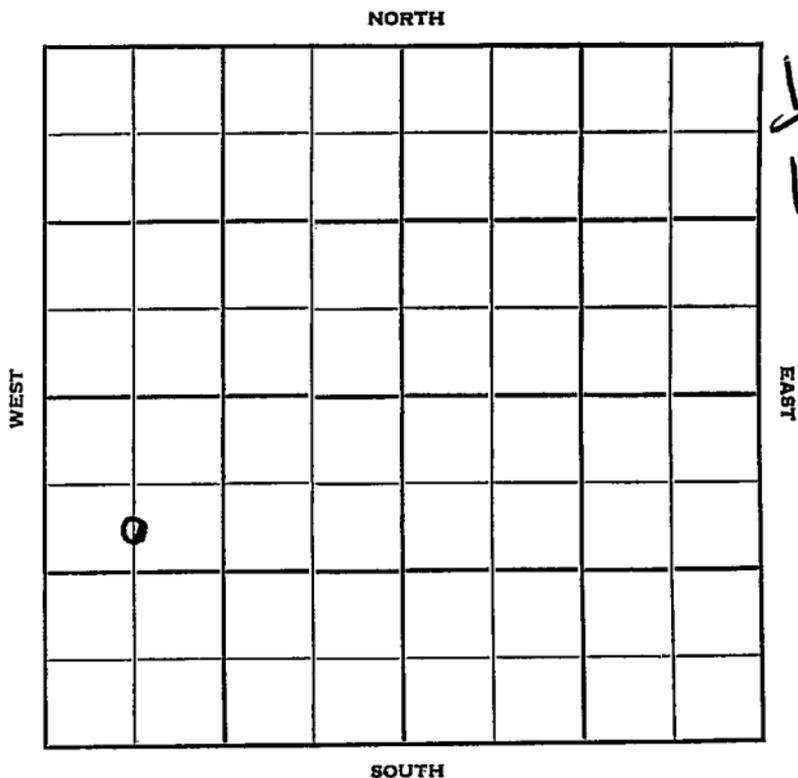



Sec. 33 Twp. 9 R. 21 W

Well No. # 2 Frazier Farm

Jones, Shelburne & Farmer Company

H-S-F Contractor

N. Cooper Pool


990 Ft. from N. Line

Ft. from S. Line

Ft. from E. Line

660 Ft. from W. Line

C S L NW SW

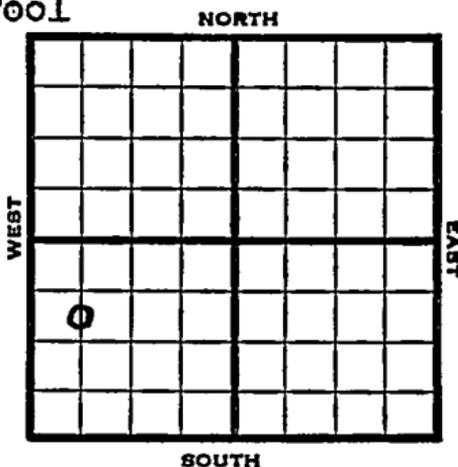

1953

Elev. 2333' REPORT

6/17

Spud 6-12-53

8" @ 160 Anhy 1803' Drlg. 2250

6/24

Spud 6-12-53

D & A TD 3935' 8" @ 160

Anhy 1803 Heeb 3521 Tor 3540

Lans 3559 Arb. 3930

TD 3935' D & A

ABANDONED

