


Graham

KANSAS

SECTION 33 TOWNSHIP 9 RANGE 21W

WELL NO. #6 Cox SWD

COMPANY Elreco Drlg.

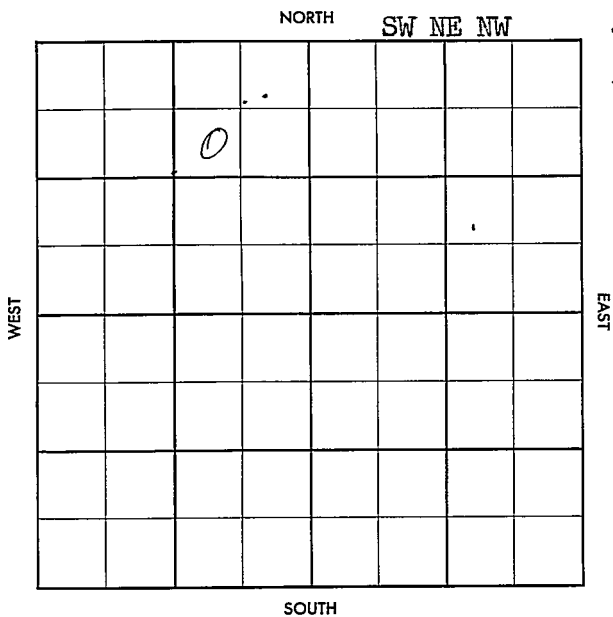

County Graham Elev. _____
 Sec. 33 Twp. 9 Rge. 21W
 Company Elreco Drilling
 FarmName Gox SWD No. 6

TOPS	DEPTH	LOG	DATUM
Anh.			
Tp.			
H.			
Tr.			
Dg.			
Bl.			
L.			
K.C.			
B.K.C.			
Ce.			
C.			
M.			
M.			
K.			
Mz.			
Me.			
V.			
S.			
S.			
A.			
R.			
PE.			
G.			
T.P.			

Loc. in Sec. _____
 SW NE NW
 Geol. _____
 Contr. _____
 K & E
 Pool _____
 Cooper _____

FIRST REPORT
 JAN 23 '77

Date Comm. _____
 Location _____

Handwritten mark resembling a stylized 'S' or '1' with a diagonal slash.

Co.
Lse.
No.
Sec.
T.
R.

County Graham Elev. 2325 DF
 Sec. 33 Twp. 29 Rge. 21W
 Company Elenco
 Farm Name Cox SWD No. 6

TOPS	DEPTH	LOG	DATUM
Anh.			
Tr.			
H.			
Tr.			
Dg.			
Bl.			
L.	3555		
K.C.			
B.K.C.			
Ce.			
C.	3879		
M.			
M.			
K.			
Mz.			
Mo.			
V.			
S.			
S.			
A.	3903		
R.			
PE.			
G.			
TD.	3915		

Loc. in Sec. S16 NE NW
02049
 Geol. _____
 Contr. R & E
 Pool _____
Cooper
 FEB 20 '57
ABANDONED

Date Comm.

Location JAMES 57 FEB 6 '57 WAS D & A.
WORT. FEB 13 '57 CO DD 4304 TD
5/2 @ 3940/200 WOCF FEB 20 '57
CO 4304 100 FT 341 BW IN
50 MINUTES COMP FOR
SWD Well

Co.
 Sec.
 No.
 Sta.
 T.
 R.