

KANSAS

FORM 51 IOM 12-46 PETROL


Graham County

Section 33 Township 9 Range 22-W

Well No. 1 Loyd

Company Anderson-Prichard

Wildcat

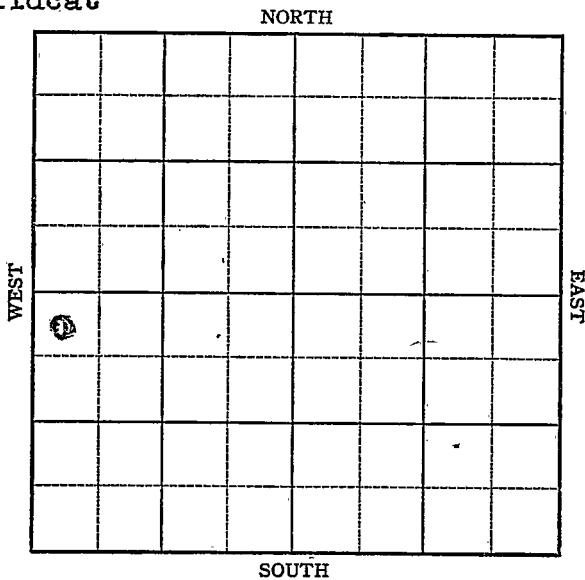

Sec. 33 Twp. 9 R. 22-W

Well No. #1 Loyd Farm

Anderson-Prichard Company

Wildcat


330 Ft. from N. Line

 Ft. from S. Line

 Ft. from E. Line

330 Ft. from W. Line

NW SW

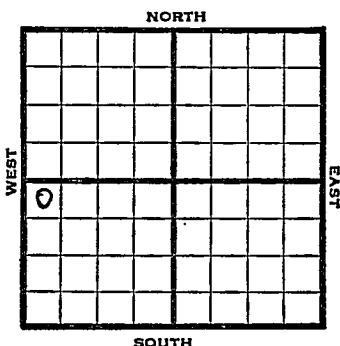

1947

El. 2367'

REPORT

7/2

Location

7/8

RUR

7-16

8" @ 235

Drlg. 270'

7/22

Lansing 3608'

T.D. 3807'

7/29

Arbuckle 4020'

TD 4117'

5" @ 3927'

RUST

8/6

Arbuckle 4020'

5" @ 3927'

TD 4117'

Abandoned

ABANDONED

Map No. _____ Sec. 33 Twp. 9 R. 22W

Well No. 1 Loyd

Anderson-Prichard Company

FIRST REPORT

Contractor

NW SW


SECTION PLAT

330 Ft. from N. Line

_____ Ft. from S. Line

_____ Ft. from E. Line

330 Ft. from W. Line

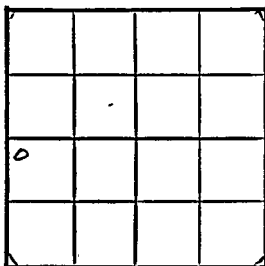

Graham County

Location X

Rig up _____

Drilling and Remarks:

RECORD

Cased _____ in., _____ ft.

Sand _____

Gas _____

Oil _____

Total Depth _____

PRODUCTION

1st 24 hrs. Nat. _____

1st 24 hrs. after shot _____

Gas _____ Cu. Ft.

Dry Hole _____

Abandoned _____

Date

JUL 2 1947 19

S. J. LEWIS Scout


Kansas Wildcat

Map No. 66 Sec. 33 Twp. 9 R. 22WWell No. 1 LoydAnderson-Prichard Company

ABANDONED

Contractor

NW SW

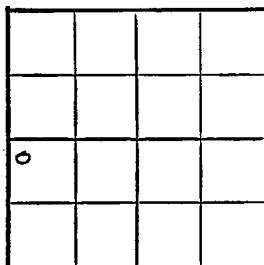EX-2367
SECTION PLAT330 Ft. from N. Line Ft. from S. Line Ft. from E. Line330 Ft. from W. Line

Graham County

Location Rig up

Drilling and Remarks:

Oil & 10205-103527

RECORD

Cased in., ft.Sand Gas Oil Total Depth 4117

PRODUCTION

1st 24 hrs. Nat. 1st 24 hrs. after shot Gas Cu. Ft.Dry Hole Abandoned

Date

AUG 6 1947 19 S. J. LEWIS Scout