

STATE CORPORATION COMMISSION OF KANSAS
OIL & GAS CONSERVATION DIVISION

WELL COMPLETION OR RECOMPLETION FORM
ACO-1 WELL HISTORY

DESCRIPTION OF WELL AND LEASE

Operator: License # 5063
Name Energy Exploration, Inc.
Address 1002 So. Broadway
City/State/Zip Wichita, KS 67211

Purchaser N/A

Operator Contact Person Brad D. Lehl
Phone (316) 267-7336

Contractor: License # 5422
Name Abercrombie Drilling, Inc.

Wellsite Geologist Ralph White
Phone (316) 263-3081

Designate Type of Completion

☒ New Well ☐ Re-Entry ☐ Workover
☐ Oil ☐ SWD ☐ Temp Abd
☐ Gas ☐ Inj ☐ Delayed Comp.
☒ Dry ☐ Other (Core, Water Supply etc.)

If ONWO: old well info as follows:

Operator N/A
Well Name
Comp. Date Old Total Depth

WELL HISTORY

Drilling Method:

☒ Mud Rotary ☐ Air Rotary ☐ Cable

3/19/85 3/28/85 3/29/85
Spud Date Date Reached TD Completion Date
4760' N/A
Total Depth PBTD

Amount of Surface Pipe Set and Cemented at 370' feet
Multiple Stage Cementing Collar Used? ☐ Yes ☒ No
If yes, show depth set feet
If alternate 2 completion, cement circulated
from N/A feet depth to w/ SX cmt

Wireline Log Rec'd

API NO. 15-193-20,347

County Thomas

NW SW SE Sec. 28 Twp. 9S Rge. 33 East West

990 Ft North from Southeast Corner of Section
2310 Ft West from Southeast Corner of Section
(Note: Locate well in section plat below)


Lease Name HERBEL "A" Well # 1

Field Name Wildcat

Producing Formation N/A

Elevation: Ground 3171' KB 3176'

Section Plat

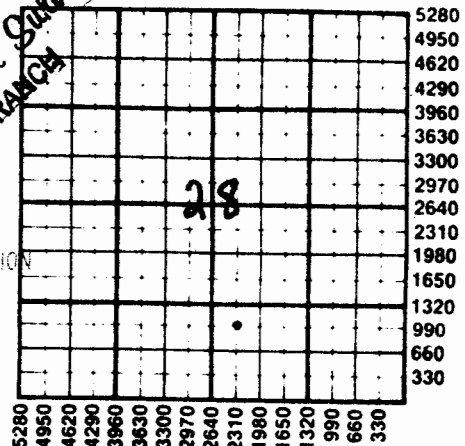

WATER SUPPLY INFORMATION

Disposition of Produced Water: ☐ Disposal
Docket # ☐ Repressuring

Questions on this portion of the ACO-1 call:

Water Resources Board (913) 296-3717

Source of Water:

Division of Water Resources Permit #

☒ Groundwater 2900 Ft North from Southeast Corner
(Well) 2200 Ft West from Southeast Corner of
Sec 28 Twp 9S Rge 33 East West

☐ Surface Water Ft North from Southeast Corner
(Stream, pond etc) Ft West from Southeast Corner
Sec Twp Rge East West

☐ Other (explain) (purchased from city, R.W.D. #)

INSTRUCTIONS: This form shall be completed in duplicate and filed with the Kansas Corporation Commission, 200 Colorado Derby Building, Wichita, Kansas 67202, within 90 days after completion or recompletion of any well. Rule 82-3-130 and 82-3-107 apply.

Information on side two of this form will be held confidential for a period of 12 months if requested in writing and submitted with the form. See rule 82-3-107 for confidentiality in excess of 12 months.

One copy of all wireline logs and drillers time log shall be attached with this form. Submit CP-4 form with all plugged wells. Submit CP-111 form with all temporarily abandoned wells.