
FORM 51 25M 8-50 WESTERN

Rooks KANSAS

Section 34 Township 9 Range 16W

Well No. #1 Becker

Company Broadview Oil

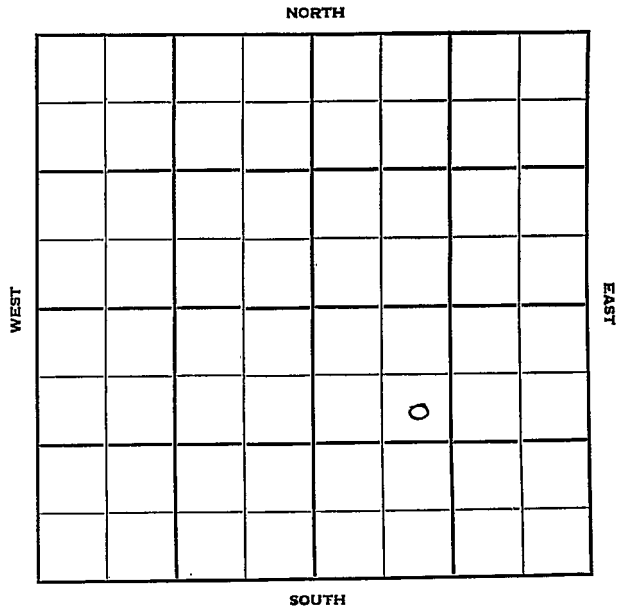

FORM 252-B
10M 10-50 PETROL

Rooks KANSAS

Sec. 34 Twp. 9 R. 16W

Well No. #1 Becker Farm

Broadview Oil Company

Tom Allen - Contr. Contractor


990' Ft. from N. Line

Ft. from S. Line

Ft. from E. Line

990' Ft. from W. Line

SE NW SE

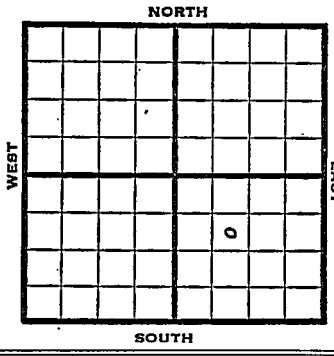

1950

Elev. 1940' REPORT

10/25 Spud 10-18-50

1951

1/10 Spud.10-18-50
Oil Well TD 3131'
8" @ 98' Anhy 1128
Neva 2248 Top 2818
Heeb. 3045 Dodge 3061
Lans. 3092 TD 3096
5" @ 3094 B 3/4 boph for 7 hr
DD 3109 1000 A S/12 boph
DD 3131 FU 2200 sw PB 3120
PB 3118 Comp. 10 bo 2 bwpd

COMPLETED

FORM 275 FOR SALE BY KANSAS BLUE PRINT CO.


County Rooks State Kansas.

Sec. 34 (Blk. Twp.) 9 (Sur. Rge.) 16W Map No.

Operator Broadview Oil

Well No. 1 Farm Becker

Elev. Location SE NW SE

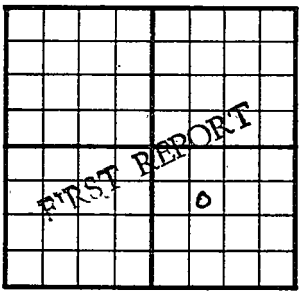

990 Ft. From N Line SE

990 Ft. From W Line Quarter

1st. Report OCT 25 1950

Completion

Remarks

Spudding Date 10-18-50

Drlg. Data

J. E. TYRA

FORM 275 FOR SALE BY KANSAS BLUE PRINT CO.


County Rooks State Kansas

Sec. 34 (Blk. Twp.) 9 (Sur. Rge.) 16W Map No.

Operator Broadview Oil

Well No. 1 Farm Becker

Elev. 1940 Location SE NW SE

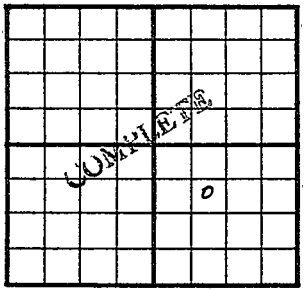

990 Ft. From N Line SE

990 Ft. From W Line Quarter

1st. Report

Completion JAN 1 0 1951

Remarks

Tom Allen - Contr.

Spudding Date 10-18-50

Drlg. Data Oil well TD 3131

8" @ 98 Anhy 1128 Neva 2248

Top. 2818 Heeb. 3045 Dodge 3061

Lans. 3092 TD 3096 5" @ 3094 B/ 3/4 bo

ph for 7 hr. DD 3109 1000 A

S/ 12 boph DD 3131 FU 2200' sw PB 3120

PB 3118 Comp. 10 bo 2 bwpd

J. E. TYRA