

Company W.L. Hartman

Wildcat

NORTH

	*						
				0			

SOUTH

KANSAS Rooks

Sec. 34 Twp. 9 R. 19-W

Well No. #1 Webster Farm

W L Hartman Company

Wildcat


 Ft. from N. Line

330 Ft. from S. Line

 Ft. from E. Line

330 Ft. from W. Line

SW S E

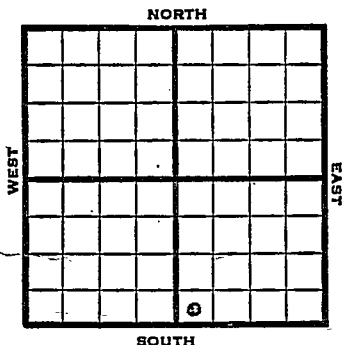

1948

Elev. 2184' REPORT

11/3

Location

11/10

RUR

11/16

8" @ 162'

11/23

Lansing 3379'

Arb. 3640'

TD 3650'

5" @ 3642'

11/30

"

12/8

"

12/15

87 shots 3640-43

37 shots 3643-47-115' oil 1 hr

12/22

TD 3652

1000 acid

Swb 27 bbls oil 8 hrs.

12/29

"

1/5

Pump 1 bbl oil PH for 6 hrs

1/12

10 qts 3643-48 SD

1/19

"

1/26

Arb. 3640'

5" @ 3642'

Lans. 3379'

Perf Lans.

TD 3652'

ABANDONED

Map No. _____ Sec. 34 Twp. 9 R. 19W

Well No. 1 Webster

W. L. Hartman Company

FIRST REPORT Contractor

SW SE


SECTION PLAT

_____ Ft. from N. Line

330 Ft. from S. Line

_____ Ft. from E. Line

330 Ft. from W. Line

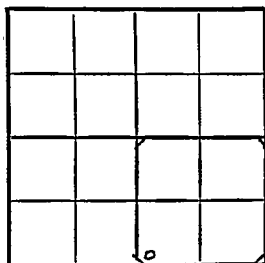

Rooks County

RECORD

Location X

Rig up _____

Drilling and Remarks:

Cased _____ in., _____ ft.

Sand _____

Gas _____

Oil _____

Total Depth _____

PRODUCTION

1st 24 hrs. Nat. _____

1st 24 hrs. after shot _____

Gas _____, Cu, Ft.

Dry Hole _____

Abandoned _____

Date

NOV 3 1948 19

S. J. LEWIS Scout

Map No. 65 Sec. 34 Twp. 9 R. 19W

Well No. 1 Webster

W. L. Hartman


Company

ABANDONED

Contractor

SW SE

E 12 184
SECTION PLAT

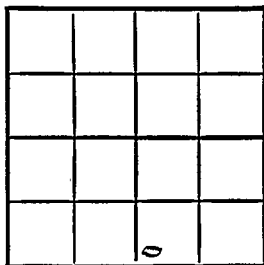

 Ft. from N. Line

330 Ft. from S. Line

 Ft. from E. Line

330 Ft. from W. Line

Rocks County

Location

Rig up

Drilling and Remarks:

Cert 3640

5" @ 3642

Home 3379

Ref Home

RECORD

Cased in., ft.

Sand

Gas

Oil

Total Depth 3652

PRODUCTION

1st 24 hrs. Nat.

1st 24 hrs. after shot

Gas Cu. Ft.

Dry Hole

Abandoned

Date

JAN 26 1949

19

S. I. LEWIS

Scout