


Section 34 Township 9 Range 20W

Well No. #3 Coddington

Company Nadel & Gussman

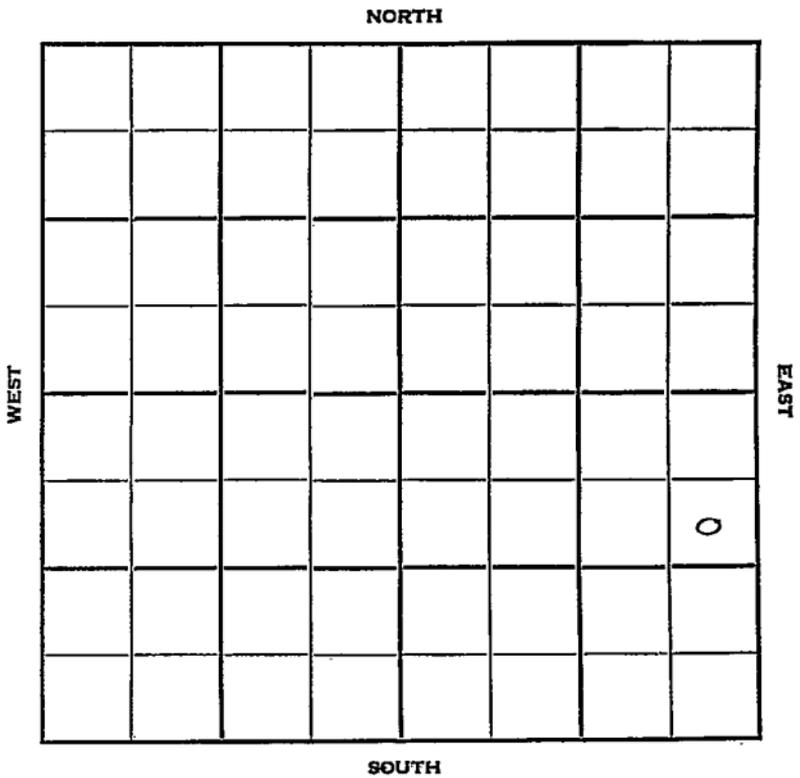

Sec. 34 Twp. 9 R. 20 W

Well No. # 3 Coddington Farm

Nadel & Gussman Company


Reserve Contractor
Hampton

990 Ft. from N. Line

_____ Ft. from S. Line

330 Ft. from E. Line

_____ Ft. from W. Line
SE NE SE

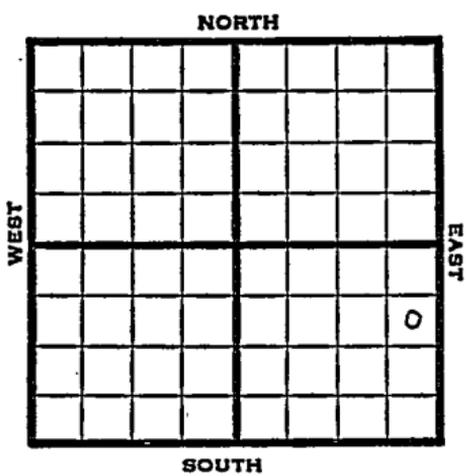

1951 Elev. 2268' REPORT

10/10

Location

10/24

Spud 10-11-51
D&A TD 3910'
8" @ 130'
Anhy 1738 Top. 3302
Heeb. 3509 Lans. 3548
B KC 3781 Cong. 3891
TD 3891'
D&A

ABANDONED

County Rooks State Kansas

Sec. 34 (Blk. Twp.) 9 (Sur. Rge.) 20W Map No.

Operator Nadel & Gussman

Well No. 3 Farm Coddington

Elev. _____ Location SE NE SE

FIRST REPORT					
					0

990 Ft. From N Line SE

330 Ft. From E Line Quarter

Ist. Report OCT 10 1951

Completion _____

Remarks _____

Reserve - Contr.

Spudding Date _____

Drlg. Data Hampton

Location

J. E. TYRA

