


Section 34 Township 9 Range 20 W

Well No. #7 Goddington

Company D. G. Hansen

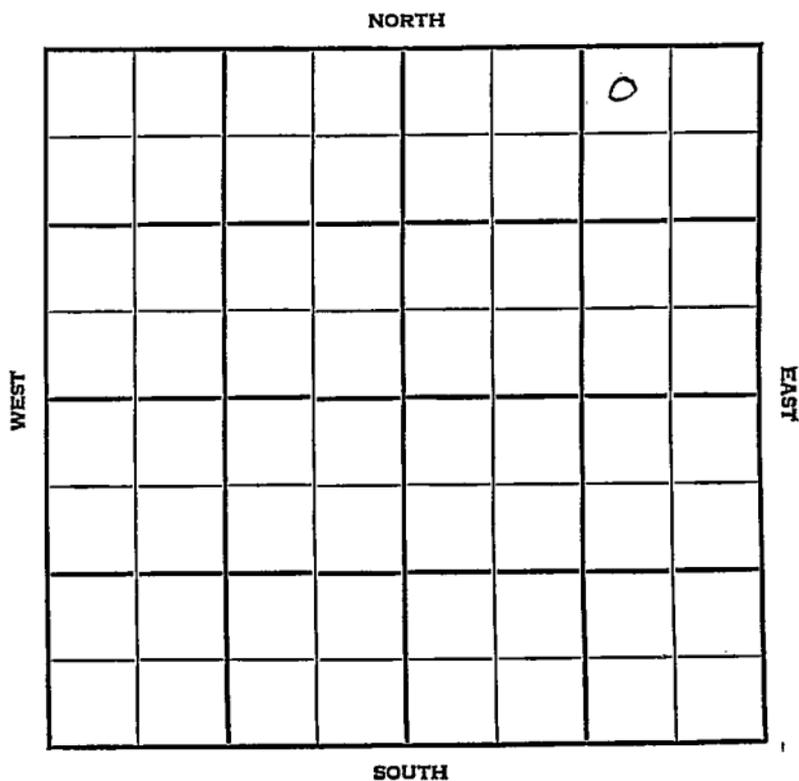

Rooks

KANSAS

SEC.	TWP.	R.
34	9	20W

WELL NO. #7 Coddington FARM

COMPANY D. G. Hansen


CONTRACTOR C & G Drlg
Northampton

_____ Ft. from N. Line

_____ Ft. from S. Line

_____ Ft. from E. Line

_____ Ft. from W. Line

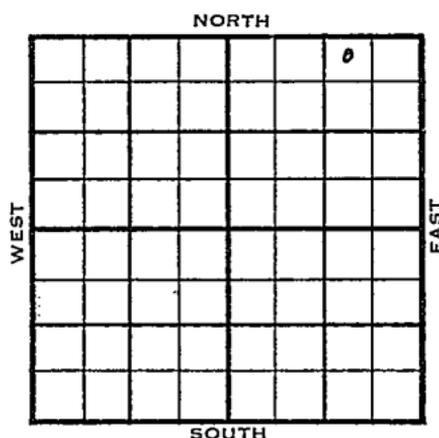

NW NE NE

1955	ELEVATION	REPORT
	2276'	
9/7	Comm 9-2-55 Anh 1744 8" @ 160/150 Drlg 2975	
11-30	DST 3602-12 op 1 hr. rec. 1085' socgsw 890/20" 5½" @ 3825 CO to 3828 FU 1400' oil 2½ hrs. DD 3829, 500 A S/ 49 BO 3 ### hrs. Comp. 77 BOPD, 27% wtr. Tp. 3313 H. 3468 Tr. 3508 L. 3525 BKC. 3745 C. 3773 S. 3801 A. 3824 TD 3828'	

COMPLETED

County Rock Elev. _____
 Sec. 34 Twp. 9 Rgs. 20W
 Company D. G. Hansen
 Farm Name Goddington No. 7

TOPS	DEPTH	LOG	DATUM
Anh.	1744		
Tp.			
H.			
Tr.			
Dg.			
Bl.			
L.			
K.C.			
B.K.C.			
Ce.			
C.			
M.			
M.			
K.			
Mz.			
Ms.			
V.			
S.			
S.			
A.			
R.			
PE.			
G.			
T.D.			

Loc. in Sec. _____
 NAME NR
 Geol. _____
 Contr. C & G Drlg.
 Pool _____
Northampton

		D

FIRST REPORT
 SEP 7 1955

Date Comm. 9-2-55
8" @ 160/150 drlg. 2975

Mandette

Co. _____
 Lse. _____
 No. _____
 Sec. _____
 T. _____
 R. _____

County Rooks Elev. 2276
 Sec. 31 Twp. 9 Rge. 20W
 Company D. G. Hansen
 Farm Name Coddington No. 7

TOPS /	DEPTH	LOG	DATUM
Anh.	1744		
Tp.	3313		1137
H.	3468		1192
Tr.	3508		1232
Dg.			
Bl.			
L.	3525		1249
K.C.			
B.K.C.	3745		1469
Ce.			
C.	3773		1497
M.			
M.			
K.			
Mz.			
Me.			
V.			
S.	3801		1525
S.			
A.	3824		1548
R.			
Pe.			
G.			
T.D.	3828		

Loc. in Sec. NW NE NE

Geol. Oil & Gas
 Contr. Northampton

		0
COMPLETE		

Date Comm. 9-2-55 NOV 30 1955
 8" @ 160/150 DST 3602-12 open 1 hr.
 rec. 1085' socgsw 890/20" 5 1/2" @ 3825
 CO to 3828 FU 1400' oil 2 1/2 hr.
 DD 3829 500 A S/ 49. bo 3 hr.
 Comp. 77 bopd 27% wtr.

Co.
No.
Sec.
T.
R.