

Rooks

KANSASSECTION 34 TOWNSHIP 9 RANGE 20 WWELL NO. #8 CoddingtonCOMPANY D. G. Hansen

NORTH

WEST								EAST

0

Rooks

KANSAS

SEC.	TWP.	R.
34	9	20W

WELL NO.

#8 Coddington

FARM

COMPANY

D.G. Hansen

CONTRACTOR

C & G Drlg.

Marcotte


Ft. from N. Line

Ft. from S. Line

Ft. from E. Line

Ft. from W. Line

SW NW SE

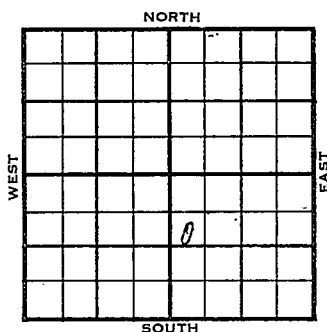

Gulf - DHM

	ELEVATION	REPORT
1955	2274'	
12-21	Comm. 12-15-55 8" @ 165/135 Drlg. 2920 Anh. 1743'	
<u>1956</u>		
1-5	DST 3868-72 op 1 hr. rec. 15' hocm, 10' mud, 320# DST 3870-76 op 35 min. rec 10' mud, 545# D & A H. 3512 Tr. 3535 L. 3551 BKC 3775 C. 3804 S. 3851 A. 3866 TD 3910	

ABANDONED

County Rocks Elev. 2274
 Sec. 31 Twp. 1 Rge. 20W
 Company D. G. Hansen
 FarmName Coddington No. 8

TOPS	DEPTH	LOG	DATUM	Loc. in Sec.
Anh.	<u>1743</u>			<u>SW NW SE</u>
TP.				
H.				
Tr.				
Dg.				
BL.				
L.				
K.C.				Geol.
B.K.C.				Contr.
Ce.				<u>C & G Drlg.</u>
C.				Pool
M.				<u>Marcotte</u>
M.				
K.				
Mz.				
Mq.				
V.				
S.				
S.				
A.				
R.				
PE.				
G.				
T.D.				

DEC 21 '55
 FIRST REPORT
 0

Date Comm. 12-15-55 Gulf - DFM

8th @ 165/135 drlg. 2920

~~X~~

County Rooks Elev. 2274
 Sec. 34 Twp. 9 Rge. 20W
 Company D. G. Hansen
 Farm Name Coddington No. 8

TOPS	DEPTH	LOG	DATUM	Loc. in Sec.
Anh.	1743			SW NW SE
Tp.				
H.	3512		1238	
Tr.	3535		1261	
Dg.				
Bl.				
L.	3551		1277	Geol.
K.C.				
B.K.C.	3775		1501	Contr.
Ce.				C & G Drlg.
C.	3804		1530	
M.				Pool
M.				Marcotte
K.				
Mz.				
Mo.				
V.				
S.	3851		1577	
S.				
A.	3866		1592	ABANDONED
R.				
Pe.				
G.				
T.D.	3910			

Date Comm. 12-15-55 JAN 5 1956

8" @ 165/135 DST 3868-72 open 1 hr.

rec. 15' hocm 10' mud 320#

DST 3870-76 open 35 min. rec. 10' mud
545#

D & A