


Section 34 Township 9 Range 20W

Well No. #9 Coddington

Company D. G. Hansen

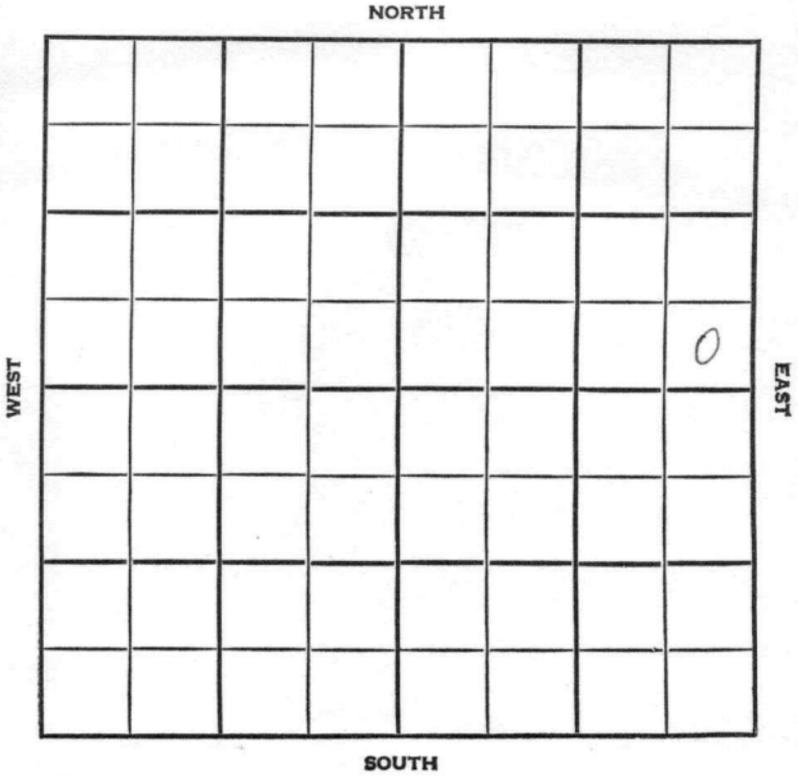

SEC. 34	TWP. 9	R. 20W
------------	-----------	-----------

WELL NO. 9
#3 Coddington FARM

COMPANY
D. G. Hansen

CONTRACTOR
C & G Drlg.


Palco

_____ FT. FROM N. LINE

_____ FT. FROM S. LINE

_____ FT. FROM E. LINE

_____ FT. FROM W. LINE

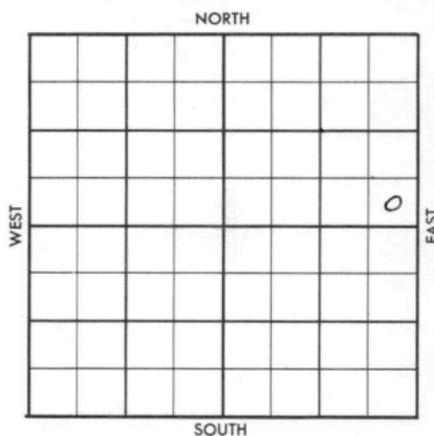

SE SE NE

1956	ELEVATION 2264'	REPORT
------	--------------------	--------

7-11 Comm. 7-7-56
8" @ 160 w/120
Drlg. 2100'

8-15 DST 3587-98 op 1 hr., 110' gas, rec.
110' HOCM / 60' mdy 0 / 40' Frothy oil
/ 20' wtr., BHP 905#.
5 1/2" @ 3812
CO 3818;
S/ 14 BOPH / tr. wtr.,
Ph. P/ 176 bopd, 45% wtr.
Anh. 1736'; H. 3472'; Tr. 3494';
L. 3510'; BKC 3733'; C. 3763';
S. 3792'; A. 3811';
TD 3818';

COMPLETED

16

County Rooks Elev. _____
 Sec. 34 Twp. _____ Rgs. 20W
 Company D. G. Hansen
 Farm Name Coddington No. 3

Co.

TOPS DEPTH LOG DATUM

Anh.			
Tr.			
H.			
Tr.			
Dg.			
Bl.			
L.			
K.C.			
B.K.C.			
Ce.			
C.			
M.			
M.			
K.			
Mz.			
Me.			
V.			
S.			
S.			
A.			
R.			
PE.			
G.			
T.D.			

Loc. in Sec. SE SE NE

Geol. _____

Contr. C & G Drlg.

Pool Palco

30	11	56

FIRST REPORT

Lse.

No.

Sec.

T.

R.

Date Comm. 7-7-56
8" @ 160/120 drlg. 2100

JUL 18 1956

R. G.

No Post on Plot sec 39
is in Glick-Marcotte Pool
CORRECTION

FORM 513 SUNRAY


TOPS	DEPTH	LOG	DATUM	Loc. in Sec.
Anh.	1736			SE ST NW
Tp.				
H.	3472			
Tr.	3494			
Dg.				
Bl.				
L.	3510			Geol.
M.C.				Cont.
B.K.C.	3733			C & S Drilling
Ce.				Pool <u>Glick</u>
C.	3763	3760		Palco
M.				
M.				
K.				
Mz.				
Mo.				
V.				
S.	3792	3789		COMPLETE
S.				
A	3811	3810		
R.				
PE.				
G.				
TD	3818	3816		

Date Comm. 7-7-56 AUG 15 '56
8" @ 160/120 drlcr. 2700 JUL 18 '56
DST 3587-98 1hr. 110' gas
near 110' HOCM + 60' Mdy 0 +
40' Frothy oil + 20' wt
BHP 905 5 1/2 @ 3812 JUL 25 '56 CO
3818 AUG 1 '56 \$ 14 Boph + Tr.
wt Pop AUG 6 '56 st Pot today
AUG 15 '56 X Ph P. 176 Bopd 45% wt
Arb O.H. 3812 - 3818 TD. 28"