


Section 34 Township 9 Range 20 W

Well No. # 6 Darrell

Company Gulf Oil

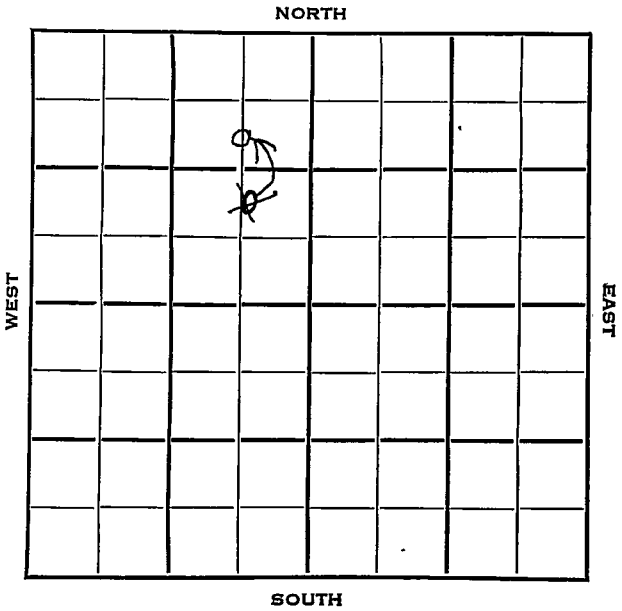

Sec. _____ Twp. _____ R. _____

#6 Darrel

Well No. _____ Farm _____

Gulf Oil

Company _____

Northampton Pool

Contractor _____

990

Ft. from N. Line

~~990~~

Ft. from S. Line


Ft. from E. Line

2070

Ft. from W. Line

~~NE SE NW~~

CSL NENW

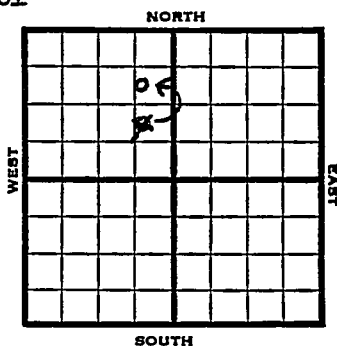

1953

Elev. 2278'

REPORT

- 8/5 Location
- 8/12 8" @ 249 w/140 Anhy 1760'
Drlg. 1768'
- 8/19 Heeb 3489 Tor 3511 Lans 3338
DST 3596-3610, 3/4 hr, 120' Very
HOcm, 620' oil 1195#
Drlg.
- 8/26 Arb 3830,
RTD 3833'
5" @ 3824'
- 9/2 CO 3833
FU 900' oil 1 1/2 hrs, S/49 BO 1st hr, S/44
BO 2 hr, S/44 BO 3rd hr, 300 A S/177
BO 3 hrs, 2200' O.B.
- 9/9 NR
- 9/16 Spud 8-2-53 Oil well TD 3833'
Anhy 1760' 9" @ 1765 Heeb 3489
Tor 3511 Lans 3538
DST 3596-3610 open 3/4 hr rec 120'
VHOcm, 620' free oil 1195#
Arb. 3830 TD 3833 5" @ 3824
CO to 3833 FU 900' oil 1 1/2 hr.
S/49 BO 1 hr. 44 BO 2nd hr.
S/44 BO 3rd hr. 300 A S/177 BO
3 hr. Comp. 3000 BOPD

COMPLETED

Map No. _____ Sec. 34 Twp. 9 R. 20WWell No. 6 DarrelGulf Oil Company**CORRECTION**

Contractor

C S L NE NW

SECTION PLAT

990 Ft. from N. Line

_____ Ft. from S. Line

_____ Ft. from E. Line

2070 Ft. from W. Line

	o		

Rooks County

Location _____

Rig up _____

Drilling and Remarks:

Reported

NE SE NW

RECORD

Cased _____ in., _____ ft.

Sand _____

Gas _____

Oil _____

Total Depth _____

PRODUCTION

1st 24 hrs. Nat. _____

1st 24 hrs. after shot _____

Gas _____ Cu. Ft.

Dry Hole _____

Abandoned _____

Date

J. G. McGEHEEAUG 12 1958

Scout

