FORM 51 25M 3-49 PETROL


KANSAS

Graham

Section 34 Township 9 Range 21-W

Well No. #1 Blazer

Company Heathman Drlg.

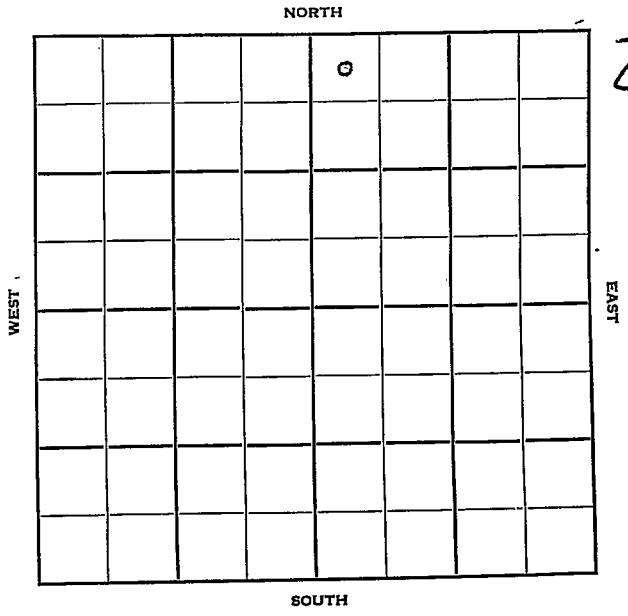

FORM 252-B
10M 9-49 PETROL

Graham KANSAS

Sec. 34 Twp. 9 R21W

Well No. #1 Blazer Farm

Heathman Drlg. Company

Heathman Drlg. Contractor


330' Ft. from N. Line

Ft. from S. Line

Ft. from E. Line

330' Ft. from W. Line

NW NW NE

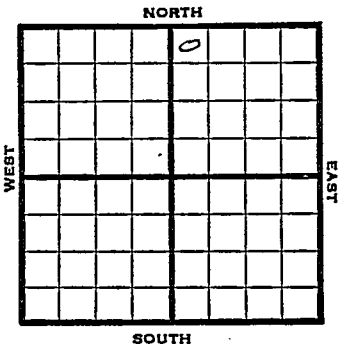

1950 Elev 2319 REPORT

5/31 Rig up

6/14 TD 3957
8" @ 130
Anhy 1783
Heeb. 3526
Topeka 3321
KC 3567
DST 3605-20, opn 40 min, rec slt wtr
BKC 3788
Cong 3842
DST 3896-3902, opn ½ hr, rec 8' mud
Arb 3944
D&A

ABANDONED

Form 26 200 Bks. 11-49 Petrol Kansas

Map No. _____ Sec. 34 Twp. 9 R. 21W

Well No. 1 Blazer

Heathman Drlg. Company

Heathman Drlg. Contractor

NW NW NE


330 Ft. from N. Line

_____ Ft. from S. Line

_____ Ft. from E. Line

330 Ft. from W. Line

SECTION PLAT

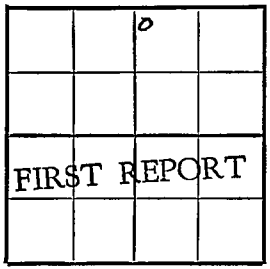

Graham

Location _____

Rig up X

Drilling and Remarks:

RECORD

Cased _____ in., _____ ft.

Sand _____

Gas _____

Oil _____

Total Depth _____

PRODUCTION

1st 24 hrs. Nat. _____

1st 24 hrs. after shot _____

Gas _____ Cu. Ft.

Dry Hole _____

Abandoned _____

Date

MAY 31 1950 19 J. E. TYRA Scout

Form 26 200 Bks. 11-49 Petrol

Kansas

Map No. _____ Sec. 34 Twp. 9 R. 21W

Well No. 1 Blazer


Heathman Drlg. Company

Contractor

NW NW NE

El. 2319

SECTION PLAT

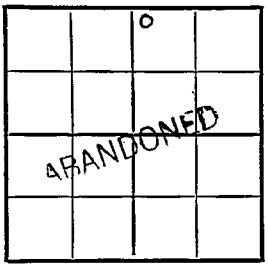

330 Ft. from N. Line

Ft. from S. Line

Ft. from E. Line

330 Ft. from W. Line

Graham County

Location

Rig up

Drilling and Remarks:

8" @ 130
Anhy 1783
Heeb. 3526
Topeka 3321
KC 3567
DST 3605-20
open 40 min.
Red. salt water

RECORD

Cased _____ in., _____ ft.

Sand

Gas

Oil

Total Depth 3957

PRODUCTION

1st 24 hrs. Nat.

1st 24 hrs. after shot

Gas _____ Cu. Ft.

Dry Hole

Abandoned

Date

JUN 14 1950

J. E. TYRA Scout

B-KC-3788
Cong. 3842
DST 3896-3902
open 1/2 hr.
Rec. 8' mud
Arb. 3944
TD 3957
D & A

JUN 19 1950

Scout Cards
Land Small Map
Land Wall Map
Tracings
Prince Map
Pierce Map
Misc.

