


Section 34 Township 9 Range 21-W

Well No. #1 De Sair

Company Phillips Pet

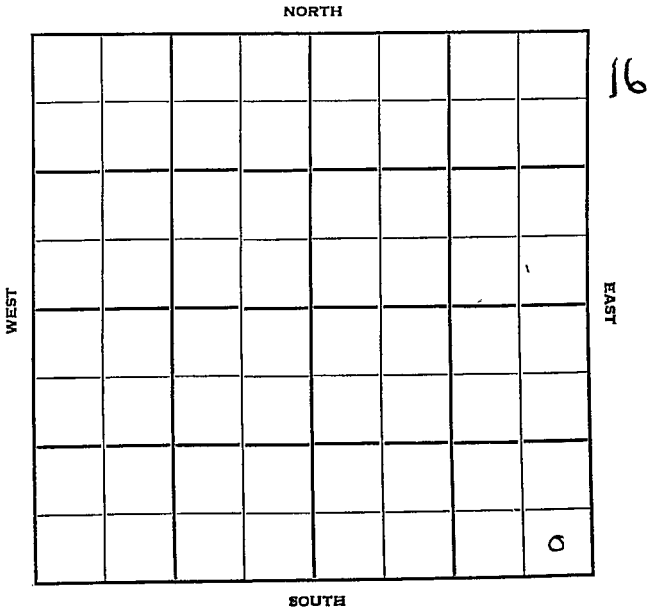

Graham KANSAS

Sec. 34 Twp. 9 R. 21W

Well No. #1 De Sair Farm

Phillips Petroleum Company

Phillips Contractor

De Young Pool

 Ft. from N. Line

330'


 Ft. from S. Line

330'

 Ft. from E. Line

 Ft. from W. Line

SE SE SE

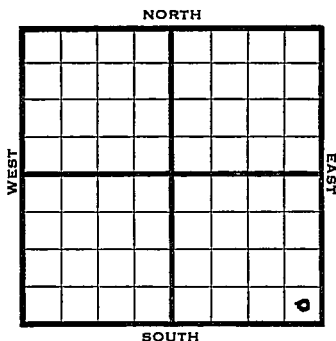


1950 Elev 2291 REPORT

8/16 Spud 8-11-50
Anhy 1770'
8-5/8" @ 1825' sks
WOC

10/4 Anhy 1770
8 5/8" @ 1825
Lans 3526 B KC 3761
Arb 3851
TD 3860
5" @ 3855 1/2
FU 225' oil 12 hr 500 A
S/7 boph 3 hr DD 3862
FU 225' oil
1000 A S/22 bo 3 hr
Comp 143 bopd
Completed

COMPLETED

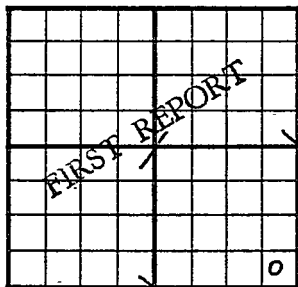
County Graham State KansasSec. 34 (Blk.) 9 (Sur.) 21W Map No.Operator Phillips PetroleumWell No. 1 Farm De SairElev. Location SE SE SE330 Ft. From S Line SE330 Ft. From E Line Quarter1st. Report AUG 16 1950

Completion

Remarks

Spudding Date 8-11-50Drlg. Data De Young PoolAnky 1770 8 5/8" @ 1825 WOC

J. E. TYRA

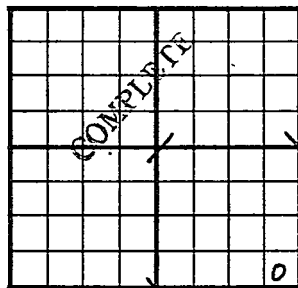County Graham State KansasSec. 34 (^{Blk.}Twp.) 9 (^{Sur.}Rge.) 21W Map No.Operator Phillips PetroleumWell No. 1 Farm DeSairElev. 2291 Location SE SE SE330 Ft. From S Line SE330 Ft. From E Line Quarter1st. ReportCompletion OCT 4 1950Remarks DeYoung PoolPhillips Pet. - Contr.Spudding Date 8-11-50Drig. Data Oil well TD 3862Anhy 1770 8 5/8" @ 1825 Lans. 3526B KC 3761 Arb. 3851 TD 38605" @ 3855 1/2 FU 225' oil 12 hr. 500 AS/ 7 boph 3 hr. DD 3862 FU 225' oil1000 A S/ 22 bo 3 hr. Comp. 143 bopd

J. E. TYRA