DX 78-1

Graham KANSAS

Section 34 Township 9 S Range 21 W

Well No. #1 Blazier

Company Herman G. Kaiser et al

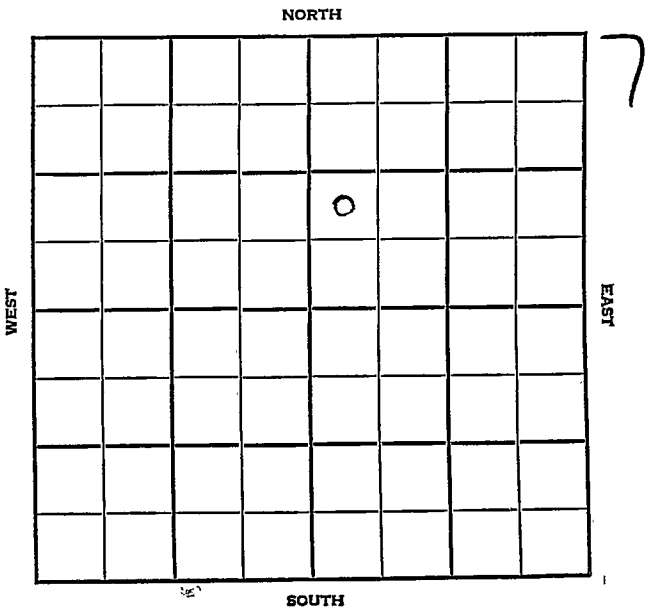

Graham KANSAS

SEC.	TWP.	R.
34	9S	21W

WELL NO.
#1 Blazier FARM

COMPANY
Herman G. Kaiser et al

CONTRACTOR
C & G
Cooper No.

_____ Ft. from N. Line

_____ Ft. from S. Line

_____ Ft. from E. Line

_____ Ft. from W. Line

NW SW NE

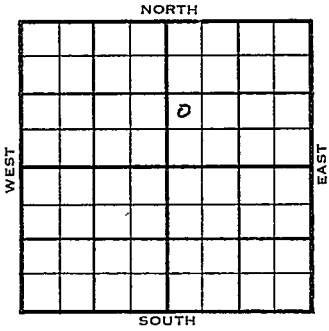

1955	ELEVATION 2290 DF 2293 RB REPORT
9/28	Loc
11/9	Comm 10-25-55 8 5/8" @ 205/125 D & A Anh 1762 H 3501 Tr 3526 L 3542 BKC 3761 C 3873 TD 3900 D & A

ABANDONED

DX-78

FORM 513 REV. SUNRAY

County Graham Elev. 2293 RB

Sec. 34 Twp. 8S Rge. 21W

Company Herman C. Kaiser etal

Farm Name Blazier No. 1

TOPS	DEPTH	LOG	DATUM
Anh.			
Tp.			
H.			
Tr.			
Dg.			
B.L.			
L.			
K.C.			
B.K.C.			
Ce.			
C.			
M.			
M.			
K.			
Mz.			
Mq.			
V.			
S.			
S.			
A			
R.			
P€.			
G.			
T.D.			

Loc. in Sec. NW SW NE

~~DS — NL — OE~~

~~Sec.~~

Geol.

Contr. C & G

Pool Cooper No.

FIRST REPORT

Date Comm. SEP 28 1955

Location

Co. Lse. No. Sec. T. R.

FORM 513 REV. SUNRAY

County Graham Elev. 2290 DF 2293 RB

Sec. 31 Twp. 6 Rge. 21W

Company Herman G. Kaiser etal.

Farm Name Blazier No. 1

TOPS	DEPTH	LOG	DATUM
Anh.	1762		
Tp.			
H.	3501		1208
Tr.	3526		1233
Dg.			
Bl.			
L.	3542		1249
K.C.			
B.K.C.	3761		1468
Ce.			
C.	3873		1580
M.			
M.			
K.			
Mz.			
Mo.			
V.			
S.			
S.			
A			
R.			
P€.			
G.			
T.D.	3900		

Loc. in Sec. NW SW NE

Geol.

Contr. C & G Drlg.

Pool N. Cooper

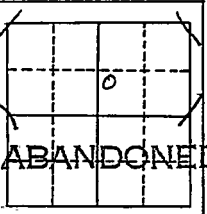

Date Comm. 10-25-55

NOV 9 1955

8 5/8" @ 205/125

D & A

Co. Lse. No. Sec. T. R.