


Section 34 Township 9 Range 21W

Well No. #1 Chem-Desair

Company Phillips Pet.

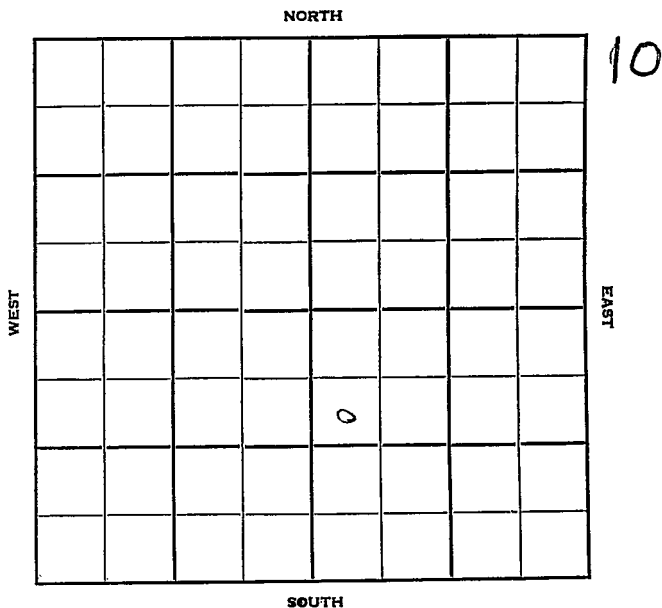

Graham  
9

**KANSAS**

21W

Sec. 34 Twp. \_\_\_\_\_ R. \_\_\_\_\_

Well No. #1 Chem-Desair Farm \_\_\_\_\_

Phillips Petr. Company \_\_\_\_\_

Wofford Drlg - Contr. Contractor \_\_\_\_\_

Cooper Pool


990' Ft. from N. Line

\_\_\_\_\_ Ft. from S. Line

\_\_\_\_\_ Ft. from E. Line

330  
~~990'~~ Ft. from W. Line

SW NW SE  
~~SE NW SE~~

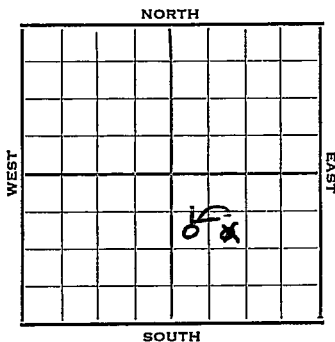

1951 Elev. 2300' REPORT

12/12 Spud 12-10-51  
8" @ 346  
WOC

1952  
1/30 Spud 12-10-51  
Oil Well TD 3879'  
8" @ 346  
Top. 3320 Heeb. 3504  
Tor. 3528 Lans. 3544  
B KC 3771 Arb. 3875  
TD 3876 5" @ 3875 CO to 3876  
S/ 2-3/4 BO 4 hr. DD 3879 1000 A  
S/ 28 BOPH 2 hr.  
Comp. 236 BOPD

**COMPLETED**



Map No. \_\_\_\_\_ Sec. 34 Twp. 9 R. 21W

Well No. 1 Chem - DeSair

Phillips Pet. Company

~~CONTRACTOR~~ Contractor

SW NW SE

SECTION PLAT

990 Ft. from N. Line

\_\_\_\_\_ Ft. from S. Line

\_\_\_\_\_ Ft. from E. Line

330 Ft. from W. Line

		o	

Graham County

Location \_\_\_\_\_

Rig up \_\_\_\_\_

Drilling and Remarks:

Reported

SE NW SE

RECORD

Cased \_\_\_\_\_ in., \_\_\_\_\_ ft.

Sand \_\_\_\_\_

Gas \_\_\_\_\_

Oil \_\_\_\_\_

Total Depth \_\_\_\_\_

PRODUCTION

1st 24 hrs. Nat. \_\_\_\_\_

1st 24 hrs. after shot \_\_\_\_\_

Gas \_\_\_\_\_ Cu. Ft.

Dry Hole \_\_\_\_\_

Abandoned \_\_\_\_\_

Date

DEC 12 1951

19

J. E. TYRA

Scout

County Graham State Kansas

Sec. 34 (Blk.) 9 (Sur.) 21W Map No.

Operator Phillips Pet.

Well No. 1 Farm Chem - Desair

Elev. 2300 Location SW NW SE


990 Ft. From N Line SE

330 Ft. From W Line Quarter

1st. Report

Completion JAN 30 1952

Remarks Cooper Pool

Wofford Drlg. - Contr.

Spudding Date 12-10-51

Drlg. Data Oil well TD 3879

8" @ 346 Top. 3320 Heeb. 3504

Tor. 3528 Lans. 3544. B KC 3771

Arb. 3875 TD 3876 5" @ 3875

CO to 3876 S/ 2 3/4 bo 4 hr. DD 3879

1000 A S/ 28 boph 2 hr.

Comp. 236 bopd