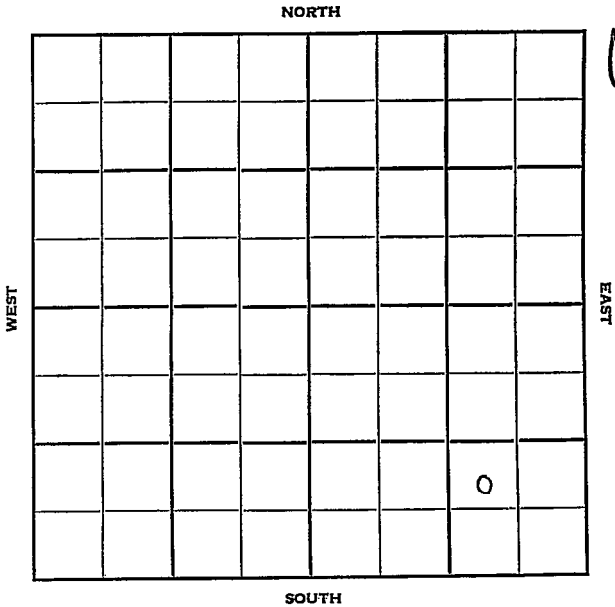


Section 34 Township 9 Range 21WWell No. #2 DeSairCompany Phillips Petroleum

Graham

KANSAS
21W

Sec. 34 Twp. 9 R. ✓

Well No. #2 DeSair Farm

Phillips Petr. Company

Phillips Pet. - Contr. Contractor

Cooper Pool


 Ft. from N. Line

990' Ft. from S. Line

990' Ft. from E. Line

 Ft. from W. Line

NW SE SE

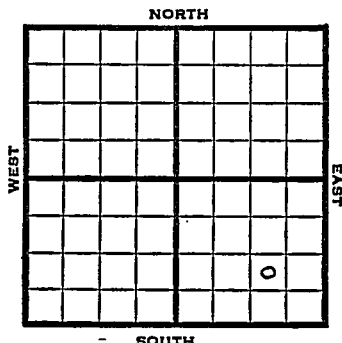

1951

Elev. 2299'

REPORT

9/12

Location

10/31

Spud 9-15-51

Oil Well TD 3877

8" @ 284

Howard 3293 Top. 3323

Heeb. 3502 Lans. 3544

B KC 3769 Arb. 3863-67

5" @ 3864 TD 3869

FU 210' oil 1 hr. DD 3871

FU 2200' oil 4 hr.

S/ 17 BO 1 hr. DD 3873

Fu 2200' oil 1 hr. S/ 15 BOPH

DD 3877 FU 2200' oil S/ 17 BOPH

Comp. 324 BOPD

COMPLETED

J. E. TYRA

County Graham State Kansas

Sec. 34 (Blk.) 9 (Sur.) 21W Map No.

Operator Phillips Petroleum

Well No. 2 Farm DeSair

Elev.	2299	Location	NW SE SE
-------	------	----------	----------

COMPLETE

990 Ft. From S Line SE

990 Ft. From E Line Quarter

1st. Report

Completion OCT 31 1951

Remarks Cooper Pool

Phillips Pet. - Contr.

Spudding Date 9-15-51

Drilg. Data Oil well TD 3877 .

8" @ 284 Howard 3293 Top. 3323

Heeb. 3502 Lans. 3544 B KC 3769

Arb. 3863-67 5" @ 3864 TD 3869

FU 210' oil 1 hr. DD 3871 FU 2200' oil

4 hr. S/ 17 bo 1 hr. DD 3873

FU 2200' oil 1 hr. S/ 15 boph DD 3877

FU 2200' oil S/ 17 boph

Comp. 324 bopd

J. E. TYRA