



Sec. 34 Twp. 9 R. 21W

Well No. #3 De Sair Farm

Phillips Pet. Company

Phillips Contractor  
Cooper


\_\_\_\_\_ Ft. from N. Line

330 Ft. from S. Line

\_\_\_\_\_ Ft. from E. Line

330 Ft. from W. Line

**SW SW SE**

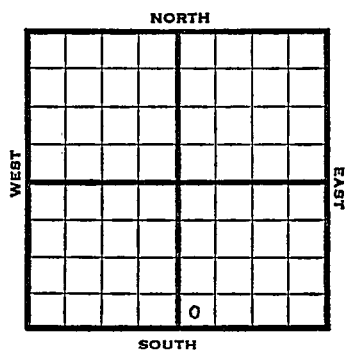

1951

Elev. 2312'

**REPORT**

11/7

**Location**

12/12

Spud 11-8-51  
 Oil Well TD 3871  
 8" @ 303'  
 Howard 3298      Top. 3329  
 Heeb. 3507      Tor. 3526  
 Lans. 3547      B KC 3775  
 Arb. 3861-65  
 5" @ 3862      CO to 3865  
 B/ 4 BOPH      DD 3871  
 S/ 55 BOPH      Comp. EPI 3000 BOPD

**COMPLETED**



