


Section 34 Township 9 Range 21W

Well No. #5 DeSair

Company Phillips

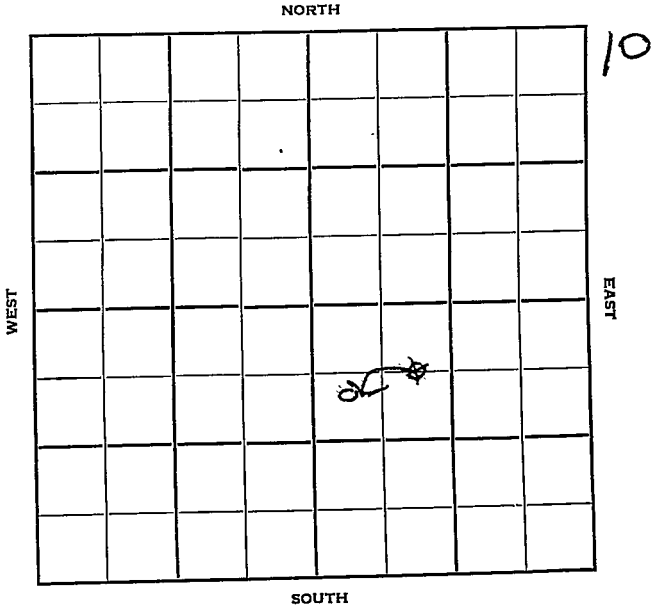

Sec. 34 Twp. 9 R. 21W

Well No. #5 DeSair Farm _____
 _____ Phillips Company _____
 _____ Contractor _____

~~890~~ Cooper Pool


~~660~~ Ft. from N. Line
~~660~~

_____ Ft. from S. Line

_____ Ft. from E. Line

~~330~~ ~~890~~ Ft. from W. Line
~~990~~

~~SW NW SE~~
~~C E/2 NW SE~~
 CEL NWSE

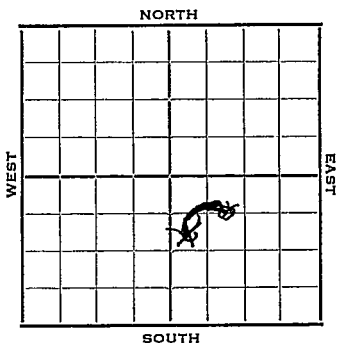

1952

Elev. 2297' REPORT

2/13

Spud 2-11-52
 8" @ 343
 WOC- --

2/20

Howard 3289 Topeka 3320' Heeb 3499'
 Tor 3524' Lans. 3542' Arb. 3868-71
 5" @ ?

3/5

Spud 2-11-52
 D&A TD 3890
 8!! @ 343 Howard 3289
 Top 3320 Heeb. 3499
 Tor. 3524 Lans. 3542
 Arb. 3868 TD 3874
 5" @ 3872 DD 3880
 500 A DD 3890
 S/3½ bw scum oil 1 hr
 SP 3664 32/3584-92 500 A
 B/10 gwph D&A

ABANDONED

County Graham State Kansas

Sec. 34 (Blk. Twp.) 9 (Sur. Rge.) 21W Map No.

Operator Phillips

Well No. 5 Farm DeSair

Elev. _____ Location C E/2 NW SE

660 Ft. From N Line SE

990 Ft. From W Line _____ Quarter

1st. Report FEB 13 1952

Completion _____

Remarks See correction

Phillips - Contr.

Spudding Date 2-11-52

Drig. Data Cooper - pool

8" @ 343 W.O.C.

J. G. McGEHEE

Kansas

Map No. _____ Sec. 34 Twp. 9 R. 21W

Well No. 5 DeSair

Phillips Pet. Company

EXPLORATION Contractor

SW NW SE

SECTION PLAT

890 Ft. from N. Line

_____ Ft. from S. Line

_____ Ft. from E. Line

330 Ft. from W. Line

		0	

Graham County

Location _____

Rig up _____

Drilling and Remarks:

Reported

C E L NW SE

Handwritten: 2111 CS 237

RECORD

Cased _____ in., _____ ft.

Sand _____

Gas _____

Oil _____

Total Depth _____

PRODUCTION

1st 24 hrs. Nat. _____

1st 24 hrs. after shot _____

Gas _____ Cu. Ft.

Dry Hole _____

Abandoned _____

Date _____

J. G. McGEHEE

Scout

FEB 27 1952 19

Map No. _____ Sec. 34 Twp. 9 R. 21WWell No. 5 DeSair

Phillips Pet. _____

Company

CORRECTION

Contractor

C E L N W S E

SECTION PLAT

660 Ft. from N. Line

_____ Ft. from S. Line

_____ Ft. from E. Line

890 Ft. from W. Line

		o	

Graham County

Location _____

Rig up _____

Drilling and Remarks:

Reporrected

from SW NW SE

RECORD

Cased _____ in., _____ ft.

Sand _____

Gas _____

Oil _____

Total Depth _____

PRODUCTION

1st 24 hrs. Nat. _____

1st 24 hrs. after shot _____

Gas _____ Cu. Ft.

Dry Hole _____

Abandoned _____

Date

MAR 5 1952

19

Scout

