


Section 34 Township 9 Range 21 W

Well No. #1 KuehnL
#1 Kuehn

Company C & G Drlg. & D. G. Hansen

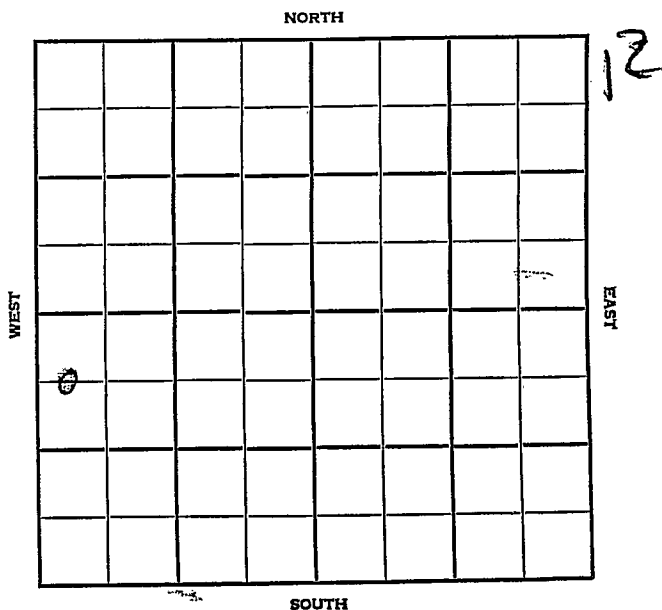

Graham

KANSAS

SEC.	TWP.	R.
34	9	21W

WELL NO. ~~#1 Kughn~~
#7 Kuchnl

FARM

COMPANY
C & G Drlg & D. G. Hansen

CONTRACTOR
Co. Tools
Cooper


660 Ft. from N. Line

Ft. from S. Line

Ft. from E. Line

330 Ft. from W. Line

C W $\frac{1}{2}$ NW SW

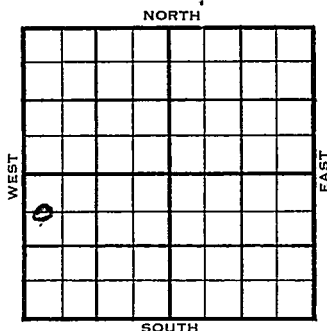

1955	ELEVATION 2308'	REPORT
------	--------------------	--------

7/27 Location
8/17 Comm: 8/5/55
8 5/8" @179 w/150 D 3260
D&A
Ang: 1770,
TP: 3301, 993
H: 3513, 1205,
Tr: 3539, 1231
L: 3552, 1244
BKC: 3775, 1467,
C: 3868, 1560
A: 3895, 1587
TD: 3815

ABANDONED

County Graham Elev. _____
 Sec. 34 Twp. 9 Rgs. 21W
 Company C & G Drilg. & D.G. Hansen
 Farm Name Kughn No. 1

TOPS	DEPTH	LOG	DATUM
Anh.			
Tp.			
H.			
Tr.			
Dg.			
Bl.			
L.			
K.C.			
B.K.C.			
Ce.			
C.			
M.			
M.			
K.			
Mz.			
Me.			
V.			
S.			
S.			
A.			
R.			
PE.			
G.			
T.D.			

Loc. in Sec. C W $\frac{1}{2}$ NW SW
 Geol. _____
 Contr. _____
 Co. tools Cooper
 Pool _____
 FIRST REPORT
 JUL 27 '55

Date Comm. _____
 Location _____

Co.
Lse.
No.
Sec.
T.
R.

Handwritten scribble

County Graham Elev. 2308
 Sec. 34 Twp. 9 Rge. 21W
 Company C & G Drilg. & D. G. Hansen
 FarmName Kuehnl No. 7

TOPS	DEPTH	LOG	DATUM
Anh.	1770		
Tp.	3301		993
H.	3513		1205
Tr.	3539		1231
Dg.			
Bl.			
L.	3552		1244
K.C.			
B.K.C.	3775		1467
Ce.			
C.	3868		1560
M.			
M.			
K.			
Mz.			
Ma.			
V.			
S.			
S.			
A.	3895		1587
R.			
Pe.			
G.			
T.D.	3915		

Loc. in Sec. C W/2 NW SW

Geol. _____
 Contr. _____
 Co. tools

Pool
Cooper

AUG 17 1955
 ABANDONED

Date Comm. 8/5/55 8 5/8 179 w/150 D 3260

D & A

Co.

Lse.

No.

Sec.

T.

R.