


Graham KANSAS

Section 34 Township 9 Range 21W

Well No. #1 Kuehnl

Company C & G Drlg.

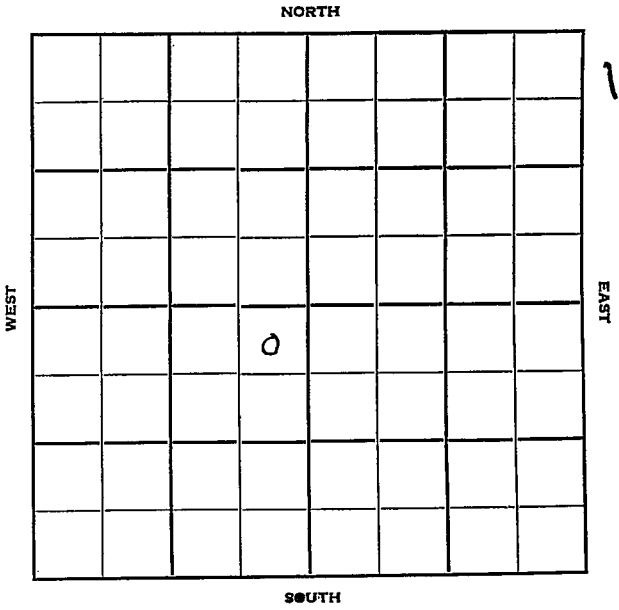

Graham

KANSAS

Sec. 34 Twp. 9 R. 21W

Well No. #1 Kuehnt Farm

C & G Drlg. Company

C & G Drlg. - Contr. Contractor

Semi-Wildcat


330' Ft. from N. Line

_____ Ft. from S. Line

330' Ft. from E. Line

_____ Ft. from W. Line

NE NE SW

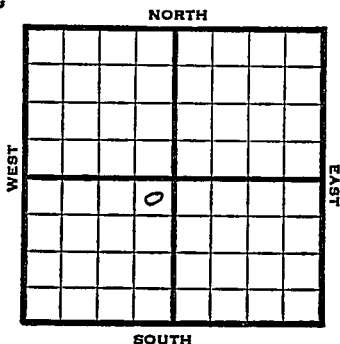

1950

-Elev 2320' REPORT

11/29

Spud 11-27-50

8" @ 245'

12/20

8" @ 245'

Anhy 1790

Heeb 3518

Toronto 3451

KC 3563

B KC 3784

Cong 3889

Arb 3903

TD 3909

5" @ 3904

10/3905-08

1000 A

DD 3927

D&A

ABANDONED

County Graham State Kansas

Sec. 34 (Blk. 9) (Sur. 21W) (Twp. Map No.)

Operator C & G Drlg.

Well No. 1 Farm Kuehnl

Elev. _____ Location NE NE SW

330 Ft. From N Line SW

330 Ft. From E Line Quarter

Ist. Report NOV 29 1950

Completion _____

Remarks Continental DHM

C & G Drlg. - Contr.

Spudding Date 11-27-50

Drlg. Data Semi Wildcat

8th @ 245

J. E. TYRA

