


Section 34 Township 9 Range 21 W

Well No. # 1 Weigel

Company C & G Drlg.

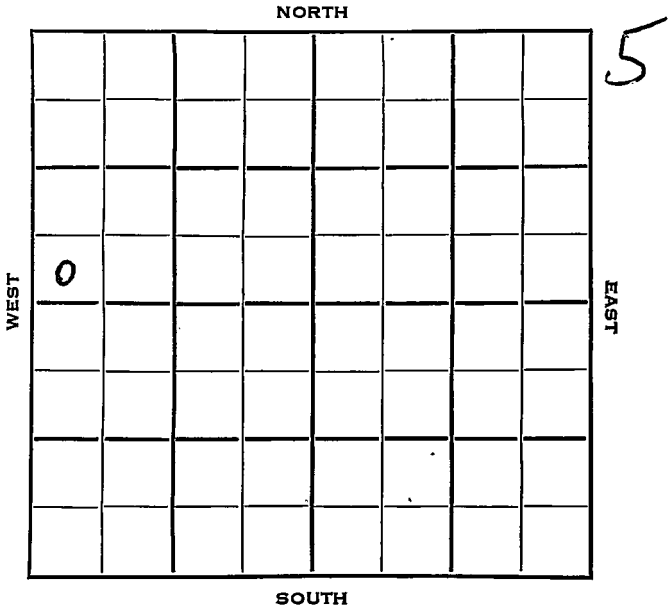

Sec. 34 Twp. 9 R. 21W

Well No. #1 Weigel Farm

C & G Drlg. Company

Wildcat Contractor


Ft. from N. Line

330 Ft. from S. Line

Ft. from E. Line

330 Ft. from W. Line

SW SW NW
Cont'l farmout

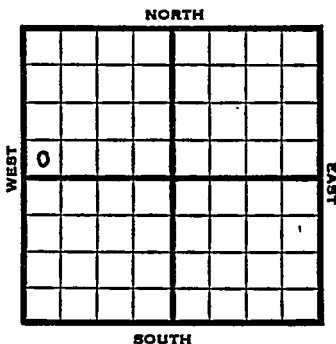

1952 Elev. 2326' REPORT

12/3 Location

12/11 8" @ 145 Ø3389

12/17 Spud 12-2-52

D&A

TD 3939'

8" @ 145

Heeb 3531, Lans 3575, B KC 3794

Cong. 3860, Arb. 3909

TD 3939

D&A

ABANDONED

