

O.W.W.O.

Graham

KANSAS

Section 34 Township 9 Range 22W

Well No. #1 Sandlin

Company Sunflower State Oil Inc.
~~Yockey Oil~~

NORTH

WEST

EAST

			0				

SOUTH

//

O.W.W.O.

Graham

KANSAS

Sec. 34 Twp. 9 R. 22E

Well No. 1 Sandlin Farm

Sunflower State Oil Inc.
Yeekey Oil

Company

Contractor

Fargo Pool


330' Ft. from N. Line

Ft. from S. Line

330' Ft. from E. Line

Ft. from W. Line

NE NE SW

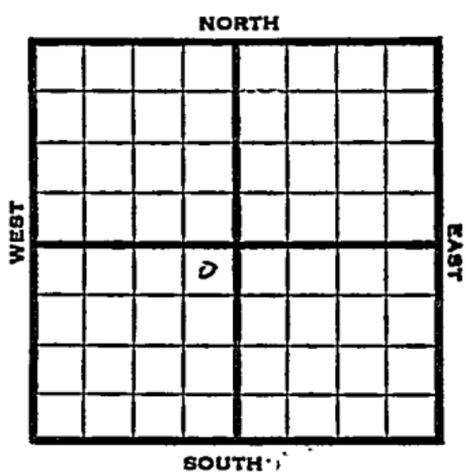

2344'

1951 Elev. ~~2329'~~ REPORT

6/13 RUR
11/7 Spud 6-13-51
8" @ 135'
Anhy 1850
Stuck at 3096 TD
Abandoned

2344
1850

494

ABANDONED
O.W.W.O.

3563
2344

1219

1952
4/30 8" @ 135' Anhy 1850'
TD 3096'. Rig blew over.
RUR

5/7 CO
5/14 Drlg. 3450'
5/21 Topeka 3304 Heeb. 3526
Lans. 3563 5" @ 3790
5/28 Cement came up 100' inside pipe.
Trying to drill out.

6/11 DP RTD 3792
6/18 CO 3782' 60/3761-72' NS
9/3756-61 10/3768-72 1000 A
B/5 bailers fluid per hr.

6/25 Shut down
7/2 On pump

OVER

1952

7/9 D & A TD 3792' 8" @ 135
 Anhy 1850' OTD 3096' Top 3304'
 Heeb 3526' Lans. 3563' 5" @ 3790
 TD 3792' CO to 3782' 60/3761-72
 9/3756-61 10/3768-72 1000 A
 B/5 bailers fluid PH D & A

1/1 NR

1/8 **ABANDONED**

1952

10/15 **O.W.W.O.**
 Lans. 3563' OTD 3792'
 5" @ 3790' RUST

10/22 NR

10/29 CO 3787' 120/3764-71 2000 A
 B/4 BOPH 6 hrs. 2100' off btm.
 POP

11/5 "

11/12 "

11/20 "

11/27 NR

12/4 NR

12/11 "

12/18 NR

12/25 NR

1/1 NR

1/8 NR

1/15 Run Sch.

1/22 "

1/29 NR

2/5 NR

2/12 NR

2/18 NR

2/26 NR

3/12 NR

3/19 NR

3/26 NR

4/2 "

4/9 "

4/16 "

4/23 NR

4/30 "

5/6 NR

I Sandlin

1953

5/21 NR

5/28 "

6/3 "

6/24 NR

7/1 "

7/22 NR

7/29 "

8/5 NR

8/12 "

9/2 D&A

TD 3792

Lans 3563

OTD 3792

5" @ 3790

CO to 3787

120/3764-71, 2000A

B/4 boph ~~5~~ 6 hrs., 2000A

D&A

ABANDONED


County Graham State Kansas

Sec. 32 (Blk. Twp.) 9 (Sur. Rge.) 22W Map No.

Operator Yockey Oil

Well No. 1 Farm Sandlin

Elev. Location NE NE SW

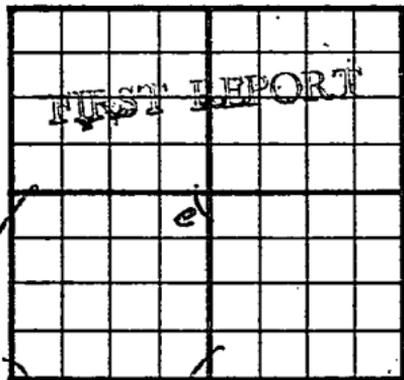

330 Ft. From N Line SW

330 Ft. From E Line Quarter

Ist. Report JUN 13 1951

Completion

Remarks

Spudding Date

Drilg. Data

R U R

Fargo Pool


County Graham State Kansas

Sec. 34 (Blk.) 9 (Sur. Rge.) 22W Map No.

Operator Yockey Oil

Well No. 1 Farm Sandlin

Elev. 2329' Location NE NE SW

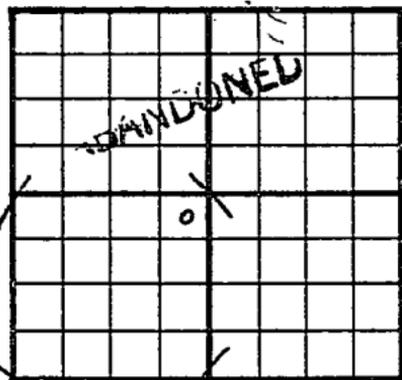

330 Ft. From N Line SW

330 Ft. From E Line Quarter

Ist. Report

Completion NOV 7 1951

Remarks Fargo Pool

Spudding Date 6-13-51

Drlg. Data

8" @ 135 Anhy 1850 Stuck at 3096 TD

Abandoned

O.W.W.O.

County **Graham** State **Kansas**

Sec. **34** (Blk. Twp.) **9** (Sur. Rge.) **22W** Map No.

Operator **Yockey Oil**

Well No. **1** Farm **Sandlin**

Elev. **2329DF** Location **NE NE SW**

FIRST REPORT

330 Ft. From **N** Line **SW**

330 Ft. From **E** Line Quarter

Ist. Report **APR 30 1952**

Completion

Remarks **OWHO**

O.W.W.O.

Spudding Date

Drlg. Data

8" @ 135 Anhy 1850 TD 3096 Rig blew over

RUR

J. G. McGEHEE

O.W.W.O.

County Graham State Kansas

Sec. 34 (Blk. 9 (Sur. Rge.) 22W Map No.

Operator Yockey Oil

Well No. 1 Farm Sandlin

Elev. 2329 Location NE NE SW

330 Ft. From N Line SW
 330 Ft. From E Line Quarter

1st. Report

Completion JUL 9 1952

Remarks O.W.W.O.

Spudding Date O.W.W.O.

Drilg. Data D & A TD 3792

8" @ 135 Anhy 1850 OTD 3096

Top. 3304 Heeb. 3526 Lans. 3563

5" @ 3790 TD 3792 CO to 3782

60/ 3761-72 9/ 3756-61 10/ 3768-72

1000 A B/ 5 bailers fluid ph

D & A

3526

2344

2344

J. G. McGEHEE

O.W.W.O.

County Graham State Kansas

Sec. 34 (Blk. Twp.) 9 (Sur. Rge.) 22W Map No.

Operator Sunflower State Oil Inc.

Well No. 1 Farm Sandlin

Elev. 2344 Location NE NE SW

FIRST REPORT					
		o			

330 Ft. From N Line SW

330 Ft. From E Line Quarter

1st. Report OCT 5 1952
O.W.W.O.

Completion _____

Remarks O.W.W.O.

Spudding Date _____

Drig. Data W. Fargo Pool

Lans. 3563 OTD 3792 5" @ 3790 RUST

2344	2563
3563	2344
81	219

O.W.W.O.

County Graham State Kansas

Sec. 34 (Blk. 9 (Sur. Rgs.) 22W Map No.

Operator Sunflower State Oil Inc. (was Yockey)

Well No. 1 Farm Sandlin

Elev. 2344 Location NE NE SW

ABANDONED					
		o			

330 Ft. From N Line SW

330 Ft. From E Line Quarter

1st. Report

Completion SEP 2 1953

Remarks O.W.W.O.

Spudding Date O.W.W.O.

Drlg. Data D & A TD 3792

Lans. 3563 OTD 3792 5" @ 3790

CO to 3787 120/ 3764-71 2000 A

B/ 4 boph 6 hr. 2000 A

D & A