
FORM 51 25M 8-50 WESTERN Graham KANSAS

Section 34 Township 9 Range 22W

Well No. #1 Walker -Russell

Company Yockey Oil

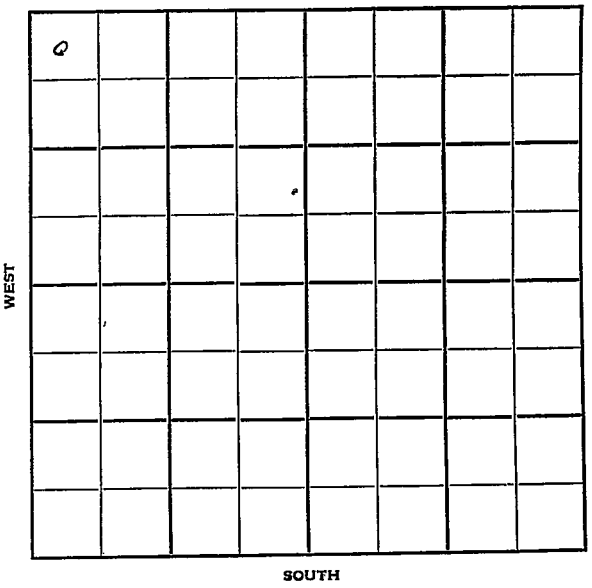

4

FORM 252-B
10M 10-50 PETROL

KANSAS

Graham

Sec. 34 Twp. 9 R. 22 W

Well No. # 1 Walker-Russell Farm

Yockey Oil Company

Contractor

Wildcat


330 Ft. from N. Line

Ft. from S. Line

Ft. from E. Line

330 Ft. from W. Line

NW NW NW

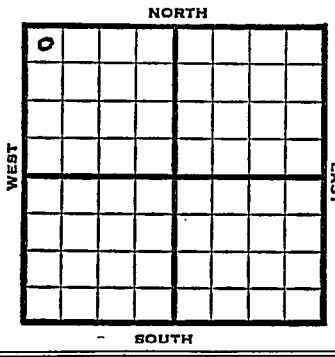

1951	Elev. 2363' REPORT
3/14	Spud 3-10-51 Drlg. 163'
4/11	Spud 3-10-51 D & A TD 4023' 8" @ 160 Anhy 1620' Top 3351' Heeb 3573' Lans 3610 DST 3638-70 open 1 hr. rec 31' mud DST 3903-18 open 1 hr. rec 20' fluid SSO Cong 3988', Arb. 3993', TD 4023' D & A **ABANDONED**

Anh Top to seem to be in error

2363
1620
743

3616
2363
247

2363
1820
543

7200
5A
657

FORM 275 FOR SALE BY KANSAS BLUE PRINT CO.


County Graham State Kansas

Sec. 34 (Blk. Twp.) 9 (Sur. Rge.) 22W Map No.

Operator Yockey Oil

Well No. 1 Farm Walker - Russell

Elev. Location NW NW NW

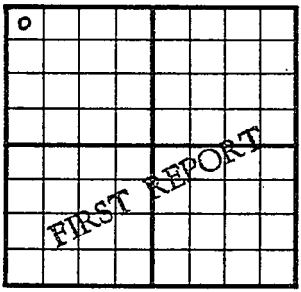

330 Ft. From N Line NW

330 Ft. From W Line Quarter

1st. Report MAR 14 1951

Completion

Remarks

Spudding Date 3-10-51

Drlg. Data Wildcat

drlg. 163

J. E. TYRA

FORM 275 FOR SALE BY KANSAS BLUE PRINT CO.


County Graham State Kansas

Sec. 34 (Blk. Twp.) 9 (Sur. Rge.) 22W Map No.

Operator Yockey Oil

Well No. 1 Farm Walker - Russell

Elev. 2363 Location NW NW NW

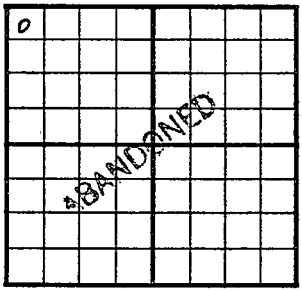

330 Ft. From N Line NW

330 Ft. From W Line Quarter

1st. Report

Completion APR 11 1951

Remarks Wildcat

check

Spudding Date 3-10-51

Drlg. Data D & A TD 4023

8" @ 160 Anhy 1620 Top. 3351

Heeb. 3573 Lans. 3610 DST 3638-70

open 1 hr. Rec. 31' mud DST 3903-18

open 1 hr. Rec. 20' fluid SSO

Cong. 3988 Arb. 3993 TD 4023

D & A

J. E. TYRA