

Section 34 Township 9 Range 23WWell No. #3 LawCompany Harry Gore

NORTH

						0	

SOUTH

WEST EAST

9

Graham

KANSAS

Sec. 34 Twp. 9 R. 23 W V

Well No. # 3 Law Farm

Harry Gore

Company

Contractor

Law Pool


990 Ft. from N. Line

Ft. from S. Line

990 Ft. from E. Line

Ft. from W. Line

SW NE SE

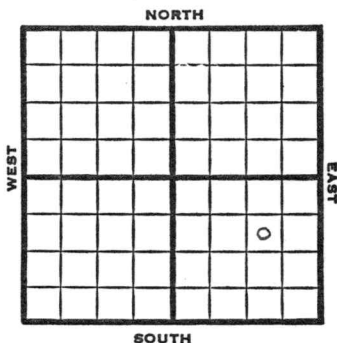

1951

Elev. 2457'

REPORT

6/6

Location

7/3

Spud 6-11-51 D & A TD 4232'
8" @ 220' Heeb 3708' Br. line 3730'
Lans. 3741' Mar. 4065' Cong 4159'
DST 3740-80 open $\frac{1}{2}$ hr. rec 297' SW
Arb. 4210'
TD 4232' D & A

ABANDONED

J. E. TYRA

County Graham State KansasSec. 34 (Blk.
Twp.) 9 (Sur.
Rge.) 23W Map No.Operator Harry GoreWell No. 3 Farm LawElev. 2457 Location SW NE SE990 Ft. From N Line SE990 Ft. From E Line Quarter

1st. Report

Completion JUL 3 1951Remarks Law PoolSpudding Date 6-11-51Drlg. Data D & A TD 42328" @ 220 Heeb. 3708 Br. lime 3730Lans. 3741 Mar. 4065 Cong. 4159DST 3740-80 open $\frac{1}{2}$ hr. Rec. 297' swArb. 4210 TD 4232D & AJ. E. TYRA