

Section 34 Township 9 Range 23WWell No. #3 C. B. LawCompany Skelly Oil

NORTH

					0		

SOUTH

WEST

EAST

2

Graham **KANSAS** ✓

Sec. 34 Twp. 9 R. 23W

Well No. #3 C. B. Law Farm

Skelly Oil Company

Law Pool


990' Ft. from N. Line

Ft. from S. Line

Ft. from E. Line

990' Ft. from W. Line

SE NW NE

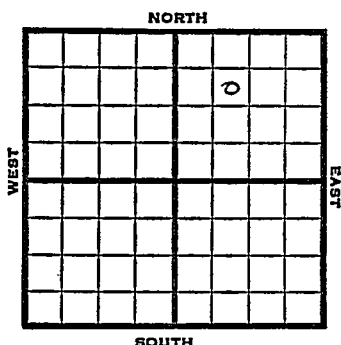

1951 Elev. 2449' REPORT

8/29 Spud 8-20-51

8" @ 235

Drlg. 3145'

10/10 Spud 8-20-51

SWD well TD 4505

8" @ 235'

Heeb. 3700 Tor. 3728

KC 3734

D T 3728-85 opn $\frac{1}{2}$ hr Rec. 950' sw
500' o & gcsw

DST 3831-34 opn 1 hr.

Rec. 95' mud Cong. 4065

Marm 4135

DST 4137-45 opn $\frac{1}{2}$ hr

Rec. 15' mud Arb. 4253

TD 4505 5" @ 4278

GO to 4249

16/4142-46

1 gwph 28/4135-42 wtr Hydrofrac


24 gfph 20% wtr PB 4106

12/3280-82 S/200 bw 10 hr.

GO to 4505 TD Comp. for SWDwell

ABANDONED

J. E. TYRA

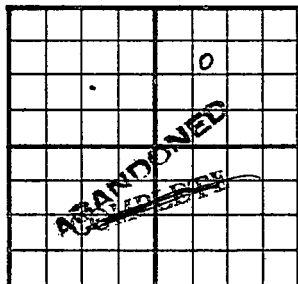County Graham State KansasSec. 34 (Blk. Twp.) 9 (Sur. Rge.) 23W Map No.Operator Skelly OilWell No. 3 Farm C. B. LawElev. 2449 Location SE NW NE990 Ft. From N Line NE990 Ft. From W Line Quarter

1st. Report

Completion OCT 10 1951Remarks Law PoolSpudding Date 8-20-51Drlg. Data SWD well TD 4505

8" @ 235 Heeb. 3700 Tor. 3728

KC 3734 DST 3728-85 open $\frac{1}{2}$ hr.

Rec. 950' sw 500' o & gcsw DST 3831-34

open 1 hr. Rec. 95' mud Cong. 4065

Marm. 4135 DST 4137-45 open $\frac{1}{2}$ hr.

Rec. 15' mud Arb. 4253 TD 4505

5" @ 4278 CO to 4249 16/ 4142-46

1 gwph 28/ 4135-42 water Hydrofrac

24 gfph 20% water PB 4106 12/ 3280-82

S/ 200 bw 10 hr. CO to 4505 TD

Comp. for SWD well

J. E. TYRA