

Graham

Section 34 Township 9 Range 23WWell No. #2 C. B. LawCompany Harry Gore

							0

NORTH

WEST

EAST

SOUTH

16

Graham

KANSAS

Sec. 34 Twp. 9 R. 23W

Well No. #2 C. B. Law Farm

Harry Gore Company


Veeder -Contr. Contractor

 Ft. from N. Line

990' Ft. from S. Line

330' Ft. from E. Line

 Ft. from W. Line

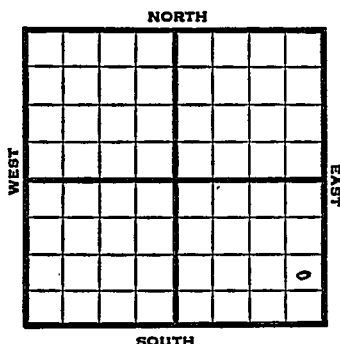

NE SE SE

1951

Elv. 2451' REPORT

5/29

Spud 5-25-51
8" @ 217
Anhy 2019
Drlg. 2100'


7/25

Spud 5-25-51
Oil well TD 4250' 8" @ 217'
Anhydrite 2019'
Topeka 3479'
Heehner 3692'
KC 3736'
B KC 3954'
DST 3807-21 open 30 min, rec 345' VHO
CM
DST 3879-3935 open 40 min, rec 235'
HOCM
Maroon 4048'
Conglomerate 4148'
Simpson 4210'
Arbuckle 4222-50'
5" @ 4167' GO to 4133'
24/4124-29 15 GOPH SP 3965'
52/ 3918-30' 62/3900-08 6000 A
3918-08' 4000 A P/25 BOPH
Comp. 1842 BOPD

COMPLETED

J. E. TYRA

County Graham State Kansas
 Sec. 34 (Blk.) 9 (Sur.) 23W Map No.
 Operator Harry Gore
 Well No. 2 Farm C. B. Law
 Elev. 2451 Location NE SE SE

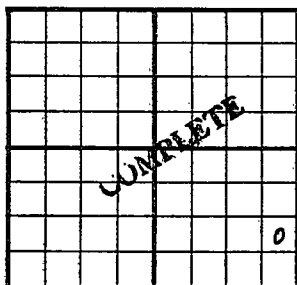

990 Ft. From S Line SE
330 Ft. From E Line Quarter
 1st. Report
 Completion JUL 25 1951
 Remarks
Veeder - Contr.
 Spudding Date 5-25-51

Drig. Data Oil well TD 4250
8" @ 217 Anhy 2019 Top. 3479
Heeb. 3692 KC 3736 B KC 3954
DST 3807-21 open 30 min. Rec. 345' vhoem
DST 3879-3935 open 40 min. Rec. 235'
hoem Mar. 4048 Cong. 4148 Simp. 4210
Arb. 4222-50 5" @ 4167 CO to 4133
24/ 4124-29 15 geph SP 3965
52/ 3918-30 62/ 3900-08 6000 A
3918-08 4000 A P/ 25 boph
Comp. 1842 bopd

J. E. TYRA