

Graham

KANSAS

34

9S

25W


SECTION _____ TOWNSHIP _____ RANGE _____

#1 Rome

WELL NO. _____

Herndon

COMPANY _____

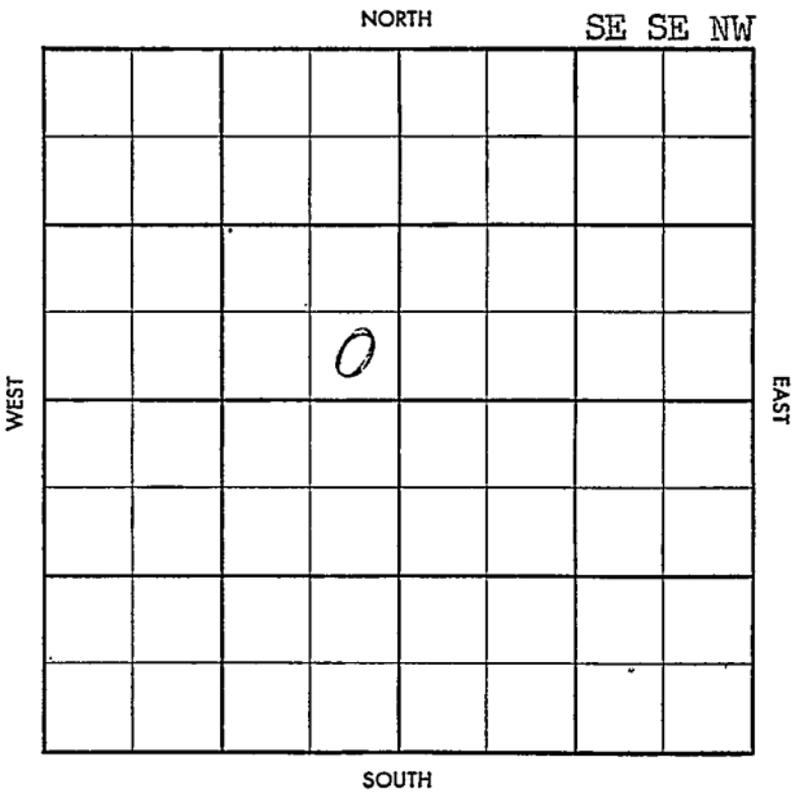

WILDCAT

S-513-A

CO. Graham ELEV. _____
SEC. 34 TWP. 9 RGE. 25W
COMPANY Herndon NO. 1

FIRST REPORT

61 30 57

FARM Rome

LOC. SE SE NW

GEOL. _____
CONTR. Co. Teels
POOL Wildcat
SPUD _____

Location

CO.
LSE.
NO.
SEC.
TWP.
RGE.

