


Graham

KANSAS
25W

SECTION 34 TOWNSHIP 9S RANGE 25W

WELL NO. #1 P. Rome Estate

COMPANY The Texas Co.

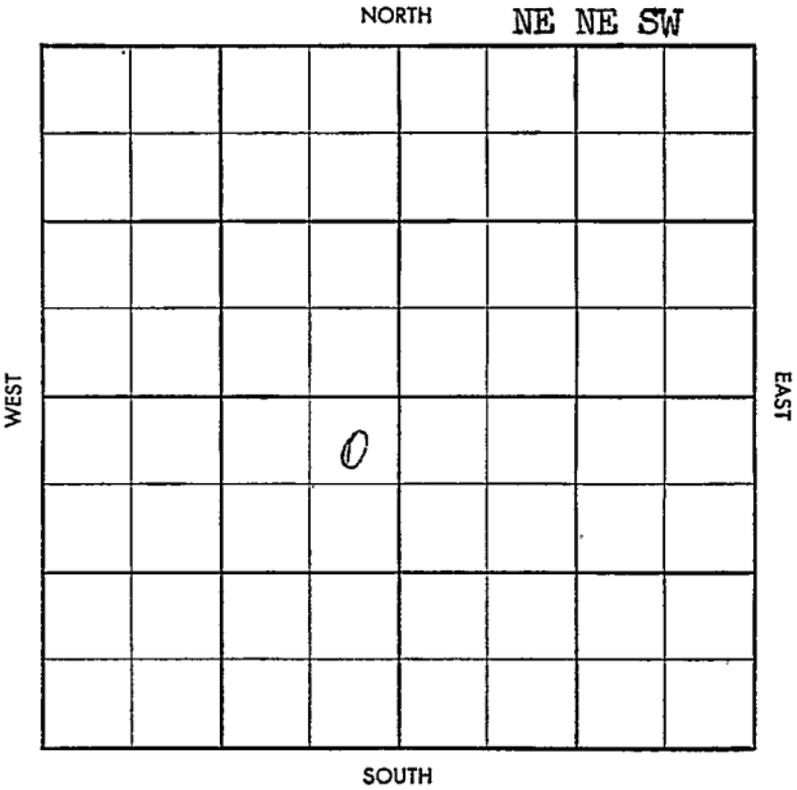

~~720-2200~~ ~~1000~~
~~1000~~ ~~1000~~

County Graham Elev. _____
 Sec. 34 Twp. 9 Rge. 25W
 Company The Texas Co.
 Farm Name P. Rome Estate No. 1

TOPS	DEPTH	LOG	DATUM
Anh.			
Tp.	3580		
H.	3800		
Tr.	3819		
Dg.			
B.L.			
L.	3836		
K.C.			
B.K.C.			
Ce.			
C.			
M.			
M.			
K.			
Mz.			
Mq.			
V.			
S.			
S.			
A.			
R.			
Pf.			
G.			
T.D.			

Loc. in Sec. _____

NE NE SW

Geol. _____

Contr. _____

Pool _____

Emor**FIRST REPORT**

JUL 30 '58

Date Comm. 7-21-58
10 3/4" @ 317 DST 3820-30 op 1 hr rec 440'
gas 100' oil 100' mco, FP 20-80#, BHP 1275#
30 running DST 3836-64

Co.

Lse.

No.

Sec.

T.

R.

~~Pool~~
~~Co. Front~~

S-513-B

County Graham Elev 25600F 25638B
 Sec. 34 Twp. 9 Rge. 25W
 Company The Texas Co.
 Farm Name P. Rome Estate No. 1

TOPS	DEPTH	LOG	DATUM
Anh.			
Tp.	3500		
H.	3800		
Tr.	3319		
Dg.			
B.L.			
L.	3836		
K.C.			
B.K.C.	4066		
Ce.			
C.			
M.			
M.			
K.			
Mz.			
Mq.			
V.			
S.			
S.			
A.			
R.			
Pf.			
G.			
T.D.	4112		

Loc. in Sec. N. NE SW
 Geol. _____
 Contr. _____
 Pool EMOR
 COMPLETE
 SEP 10 '58

Date Comm. 7-27-58
 IO 3/4" @ 317 DST 3820-30 on 1 nr rec 440'
 gas 100' oil 100' mco, FP 20-80#, DHP 1275#/
 30 running DST 3836-64 AUG 5 '58 failed
 DST 3840-76 1hr 1785' gas mco
 900' CO. 90' SW FRHP 1315/30
 7" fill mict AUG 13 '58 28/3994
 400' 1500A \$192 BO. 3994
 3hrs NWDP AUG 23 '58
SEP 10 '58 Phy 135 BO. NW 24hrs 400'
 Lss C

Co. No. 7 Sec. 1