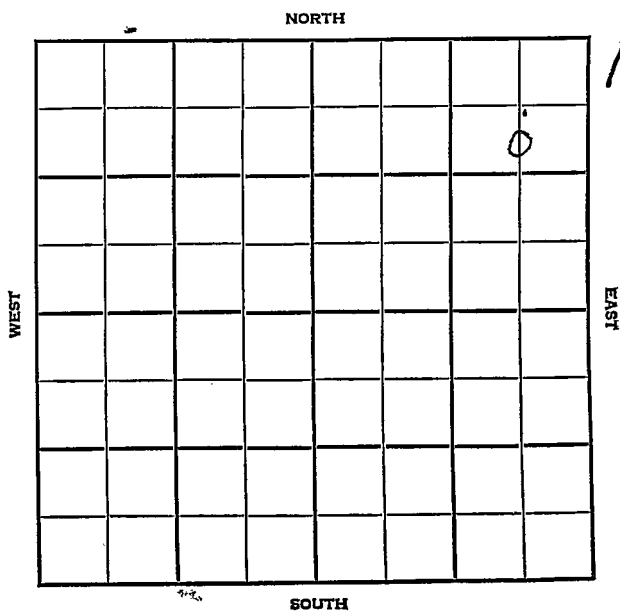


DX 78-1

Rooks

Section 35 Township 9E Range 20NWell No. 3 Pywell "B"Company T. O. Miller

Rooks

KANSAS

SEC.	TWP.	R..
35	9S	20W

WELL NO.

#3 Pywell "B"

FARM

COMPANY

I. O. Miller

CONTRACTOR

Virginia Drlg.

Eagle Creek


_____ Ft. from N. Line

_____ Ft. from S. Line

_____ Ft. from E. Line

_____ Ft. from W. Line

C S/2 NE NE

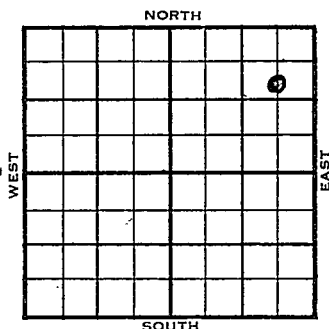

	ELEVATION	REPORT
1955	2255'	

7/20 Comm. 7/15/55
8" 222 w/150 D2300
Anh. 1703

10/5 Comm 7-15-55
8" @ 222/150
Anh 1703
H 3478
Tr 3500
L 3518
~~372~~ BKC 3728
C 3772
S 3789
A 3814

TD 3820

DST 3670-3715 open $\frac{1}{2}$ hr Rec 305'

mud DST 3816-20 open 1 hr. Rec 690'

oil 860/15" TD 3820 5 $\frac{1}{2}$ " @ 3815

CO to 3820 DD 3822 500 A

S/27 boph S/14 boph Comp 275 bopd

COMPLETED

County Rooks Elev. _____
 Sec. 35 Twp. (98) Rge. 20W
 Company I. O. Miller
 Farm Name Pywell "B" No. 3

TOPS	DEPTH	LOG	DATUM	Loc. in Sec.
Anh.	<u>1703</u>			<u>C S/2 NE NE</u>
Tr.				
H.				
Tr.				
Dg.				
BL.				
L.				
K.C.				Geol. _____
B.K.C.				Contr. _____
Ce.				<u>Virginia Drlg</u>
C.				
M.				Pool _____
M.				<u>Eagle Creek</u>
K.				
Mz.				
Mq.				
V.				
S.				
S.				
A.				
R.				
Pe.				
G.				
T.D.				

Date Comm. 7/15/55 8⁰⁰. 222 w/150
 D 2300

Marlotte

Co.

Lg.

No.

Sec.

T.

R.

County Rooks Elev. 2255
 Sec. 35 Twp. 9N Rge. 20W
 Company I. O. Miller
 Farm Name Pywell "B" No. 3

TOPS	DEPTH	LOG	DATUM	Loc. in Sec.
Anh.	1703			C S ₁ ¹ / ₂ NE NE
Tr.	3478		1223	
Dg.	3500		1245	
Bl.				
L.	3518		1263	Geol.
K.C.				Contr.
B.K.C.	3728		1473	Virginia
Ce.				
C.	3772		1577	
M.				
M.				Pool
K.				Eagle Creek
Mz.				
Ma.				
V.				
S.	3789		1534	COMPLETE
S.				
A.	3814		1554	
R.				
Pe.				
G.				
TD.	3820			

Date Comm. 7-15-55 OCT 5 1955

8" @ 222/150 DST 3670-3715 open $\frac{1}{2}$ hr.

Rec. 305' mud DST 3816-20 open 1 hr.

Rec. 690' oil 860/15" TD 3820

5 $\frac{1}{2}$ " @ 3815 CO to 3820 DD 3822

500 A S/ 27 boph S/ 14 boph

Comp. 275 bopd