

DX 78-1


Rooks

KANSAS

Section 35 Township 9 Range 20 W

Well No. # 2 Allphin

Company Elreco

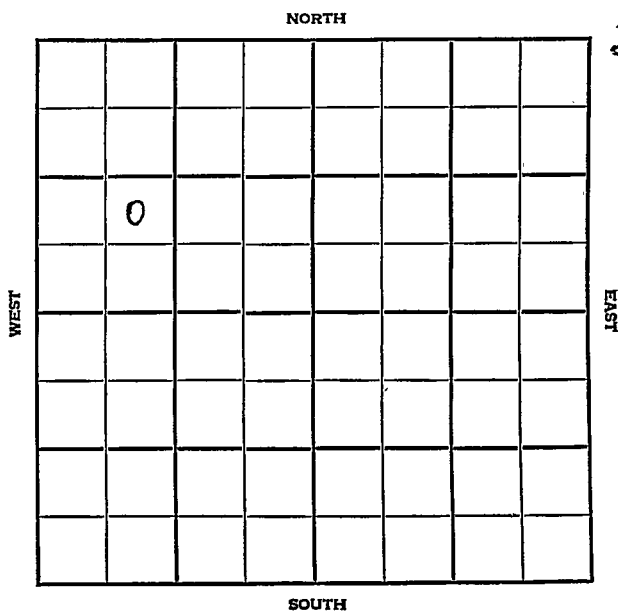

Rooks

KANSAS

SEC.	TWP.	R.
35	9	20 W

WELL NO.

2 Allphin

FARM

COMPANY

Elreco

CONTRACTOR

Sterling

N. Hampton Pool


Ft. from N. Line

990 Ft. from S. Line

Ft. from E. Line

990 Ft. from W. Line

NE SW NW

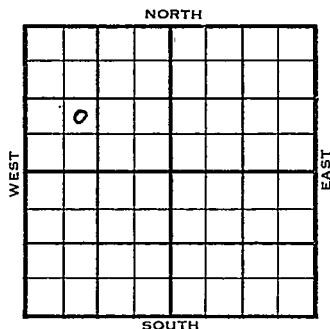

	ELEVATION	REPORT
1954	2268'	
8/11	MIR	
9/15	Spud 8-10-54 Oil well TD 3849 8-5/8" @ 240 Heeb 3491 Tor. 3513 Lans 3533 Cong 3793 Simp. 3825 Arb. 3846 DST 3846-49 1/2, open 1/2 hr FU 300' oil 970# TD 3849 5" @ 3846 CO to 3849 3849' FU 465' oil 3 hr. S/16.8 BO 4 hr. FU 1500' oil 15 hr. Comp. 136 BOPD 9% wtr.	

COMPLETED

County Rooks State KansasSec. 35 (Blk. Twp.) 9 (Sur. Rge.) 20W Map No.Operator ElrecoWell No. 2 Farm AllphinElev. 2268 Location NE SW NW

990 Ft. From S Line NW990 Ft. From W Line Quarter

1st. Report

Completion SEP 15 1954Remarks N. Hampton Pool
Sterling - Contr.Spudding Date 8-10-54Drlg. Data Oil well TD 38498 5/8" @ 240 Heeb. 3491Tor. 3513 Lans. 3533 Cong. 3793Simp. 3825 Arb. 3846 DST 3846-49 1/2 open 1/2 hr. FU 300' oil970# TD 3849 5" @ 3846 CO to3849 FU 465' oil 3 hr. S/ 16.8bo 4 hr. FU 1500' oil 15 hr.Comp/ 136 bopd 9% wtr.

FABEN GILSTRAP