

ROOKS

KANSAS

35

9S

20W

SECTION _____ TOWNSHIP _____ RANGE _____


#3 Allphin

WELL NO. _____

COMPANY Elreco

NORTH

WEST

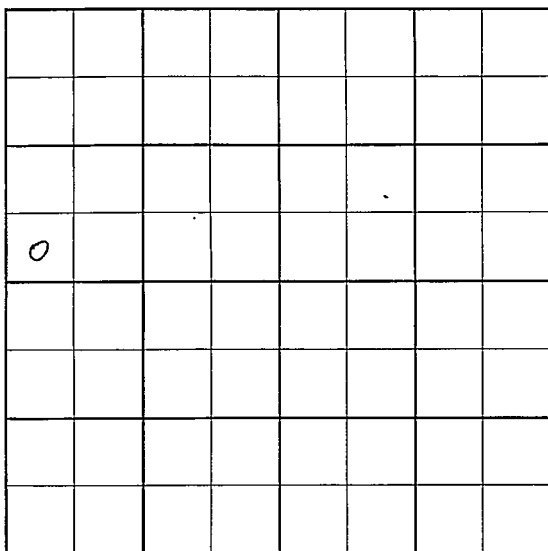

EAST

SOUTH

1

SEC.	TWP.	R.
35	9S	20W

WELL NO.

#3 Allphin

FARM

COMPANY

Elreco

CONTRACTOR

K & E Drlg.


_____ FT. FROM N. LINE

_____ FT. FROM S. LINE

_____ FT. FROM E. LINE

_____ FT. FROM W. LINE

SW SW NW

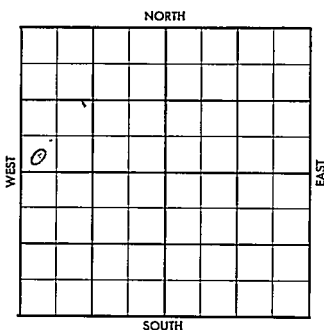

	ELEVATION	REPORT
1956	2261'	
6-13	Comm. 6-20-56	
8-8	8 5/8" @ 251 w/250 DST 3596-3604 op 1 hr., rec. 1060' SM& OCSW, BHP 1060/20". 5 1/2" @ 3814 w/75 GO 3817 B/ wtr / scum oil DD 3820 FU 1250' oil, 3 hrs. / wtr. S/ 80 BO / 461 BW, 24 hrs. P/ 30 bopd, 90% wtr. H. 3476'; Tr. 3499'; L. 3516'; BKG 3736'; C. 3766'; A. 3813'; TD 3817'	COMPLETED

County Rooks Elev. _____
 Sec. 35 Twp. 25 Rge. 20W
 Company Elreco
 Farm Name Allphin No. 3

TOPS	DEPTH	LOG	DATUM	Loc. in Sec.
Anh.				SW SW NW
Tr.				
H.				
Tr.				
Dg.				
Bl.				
L.				Geol.
K.C.				Contr.
B.K.C.				K & F. Dalg.
Ce.				Pool Glick -
C.				MARCOTTE
M.				
M.				
K.				
Mz.				
Me.				
V.				
S.				
S.				
A.				
R.				
PE.				
G.				
T.D.				

FIRST REPORT

JUN 13 '56

Date Comm. 6/20/56

JUL 1 1956

R. C.

County Roarks Elev. 2261
 Sec. 35 Twp. 9S Rge. 20W
 Company Elreco
 Farm Name Allphin No. 3

TOPS	DEPTH	LOG	DATUM	Loc. in Sec.
Anh.				SW SW NW
TP.				
H.	3476			
Tr.	3499			
Dg.				
Bl.				
L.	3516			Geol.
K.C.				
B.K.C.	3736			Contr.
Ce.				K & E Drills
C.	3766			Pool Click
M.				Margoffe
M.				
K.				
Mz.				
Mo.				
V.				
S.				
S.				
A.	3813			
R.				
Pe.				
G.				
TD.	3817			

COMPLETE
AUG 8 '56

Date Comm. 6/20/56 JUN 20 '56 25/8 251/250

17 29.35 JUN 27 '56 DST 3596-3604

1 hr. sec 1060' SM & OC SW BHP

1060/20" 5 1/2 @ 3814/75 JUL 3 '56

CO 3817 RTD 1/2 Wt. + 500m oil

DD 3820 FU 1250' oil 3 hrs + wt

80 B0 + 461 BW 24 hr. JUL 11

POP JUL 18 '56 JUL 23 '56 AUG 1 '56

AUG 8 '56 X Ph P. 30 Bopd 90% wt

ARK O.H. 3814 - 3820 TD