


Section 35 Township O.W.D.D. 9 Range 20W  
Well No. 2 Pywell "B"  
Company I. O. Miller ELDORADO REF.

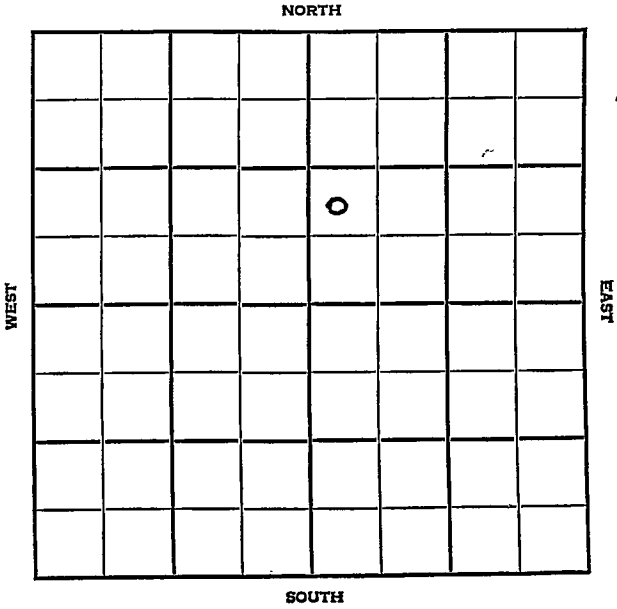

O.W.D.D. Hooks

KANSAS

|      |      |      |
|------|------|------|
| SEC. | TWP. | R.   |
| 35   | 9    | 20 W |

WELL NO.

# 2 Pywell "B"

FARM

COMPANY

~~I. O. Miller~~ EL DORADO REF

CONTRACTOR

Virginia Drlg.

~~Eagle Creek Pool~~

Marcotte Pool


Ft. from N. Line

990 Ft. from S. Line

Ft. from E. Line


330 Ft. from W. Line

NW SW NE

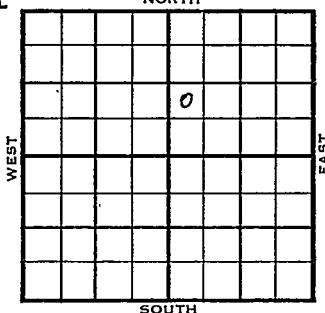

|       | ELEVATION   | REPORT |
|-------|---|--------|
| 1954  | 2233'   |        |
| 10/6  | MIR   |        |
| 10/20 | Spud 10-7-54 - D&A<br>TD 3861'<br>8" @ 218'<br>Anhy 1686', Heeb 3458', Tor 3481',<br>Lans 3498', B KC 3718', Cong 3851'<br>TD 3861'<br>D&A                        |        |
| 1955  | <b>ABANDONED</b><br><b>O.W.D.D</b>   |        |
| 3/30  |   |        |
| 4/13  | OWDD for SWD.<br>Cong. 3851'<br>OTD 3861'<br>DD 4105'   |        |
|       | SWD Well<br>TD 4240'<br>Cong 3759'<br>OTD 3861 - DD 4105<br>Arb. 3851'<br>DD 4240'<br>5" @ 3915'<br>CO to 4240, 500 M-A, 2500A<br>Comp. SWD Well - Input 384 bwph |        |

FABEN GILSTRAP

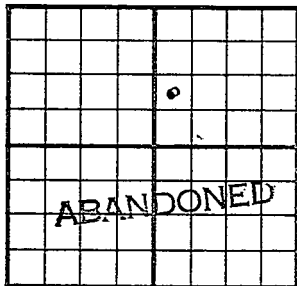County \_\_\_\_\_ Rooks \_\_\_\_\_ State KansasSec. 35 (<sup>Blk.</sup><sub>Twp.</sub>) 9 (<sup>Sur.</sup><sub>Rge.</sub>) 2 OW Map No. \_\_\_\_\_Operator I. O. MillerWell No. 2 Farm Pywell "B"Elev. 2233 Location NW SW NE990 Ft. From S Line NE330 Ft. From W Line Quarter

1st. Report \_\_\_\_\_

Completion OCT 20 1954Remarks Eagle Creek PoolVirginia Drlg. - Contr.Spudding Date 10-7-54Drlg. Data D & A TD 38618" @ 218 Anhy 1686 Heeb. 3458Tor. 3481 Lans. 3498 B KC 3718Cong. 3851 TD 3861D & A

FABEN G. LSTRAP

Cong. 3851    OTD 3861    DD 4105

FABEN GILSTRAP


County \_\_\_\_\_ Rocks \_\_\_\_\_ State Kansas

Sec. 35 (Blk.) 9 (Sur.) 20W Map No. \_\_\_\_\_  
(Twp.)

Operator Eldorado Ref. & I. O. Miller

Well No. 2 Farm Pywell "B"

Elev. 2233 Location NW SWNE

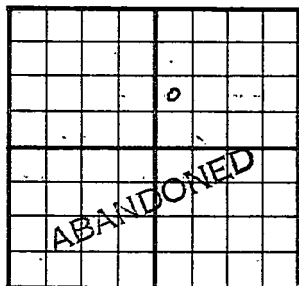

990 Ft. From S Line NE

330 Ft. From W Line Quarter

Ist. Report \_\_\_\_\_

Completion APR 13 1955

Remarks Marcotte Pool

Spudding Date \_\_\_\_\_

Drlg. Data SWD well TD 4240

Cong. 3759 OTD 3861 DD 4105

Arb. 3851 DD 4240 5" @ 3915

CO to 4240 500 M-A 2500 A

Comp. SWD well Input 384 bwph

FABEN GILSTRAP