

Rooks


FORM 51

KANSAS

Section 35 Township 9 Range 20W

Well No. #3 Wilson "C"

Company Francis Oil & Gas

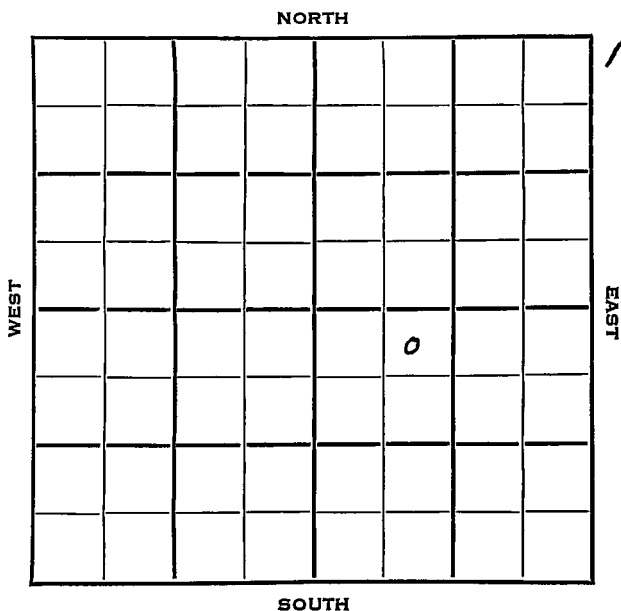

Rooks

KANSAS

SEC.	TWP.	R.
35	9	20 W ✓
WELL NO. # 3 Wilson "C" FARM		
COMPANY Francis Oil & Gas		
CONTRACTOR Armer		

Eagle Creek Pool


150 Ft. from N. Line

Ft. from S. Line

Ft. from E. Line

990 Ft. from W. Line

NE NW SE

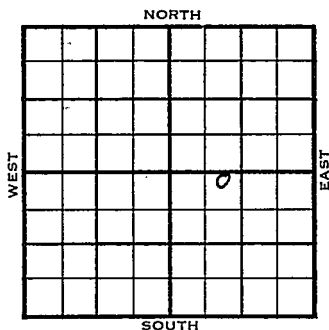

	ELEVATION	REPORT
1954	2249'	
2/10	Spud 2-3-54 Anhy 1685' Drlg. 2600'	
2/17	8" @ 220 Heeb 3433 Tor 3477 Lans. 3495 DST 3570-82 1 hr, 1435' free oil 1600# DST 3640-85, 1 hr, 363' HO & GCM 1050# Drlg. 3715'	
2/24	Arb. 3780 DST 3799-3812, 1 hr, 2465' oil 1100# RTD 3812 5" @ 3799 CO 3812	
3/3	S/68 BOPH POP	
3/10	NR	
3/17	"	

OVER

1954
3/24

Spud 2-3-54
Oil Well
TD 3812'
Anhy 1685'
8" @ 220'
Heeb 3433', Tor 3477', Lans 3495'
DST 3570-82', opn 1 hr., rec. 1435'
free oil, 1100#
DST 3640-85', opn 1 hr., rec. 363'
ho & gcm, 1050#
Arb. 3780'
DST 3799-3812', opn 1 hr., rec. 2465'
oil 1100#
TD 3813'
5" @ 3799'
CO to 3812'
S/68 boph
Comp. 3000 bopd

COMPLETED

