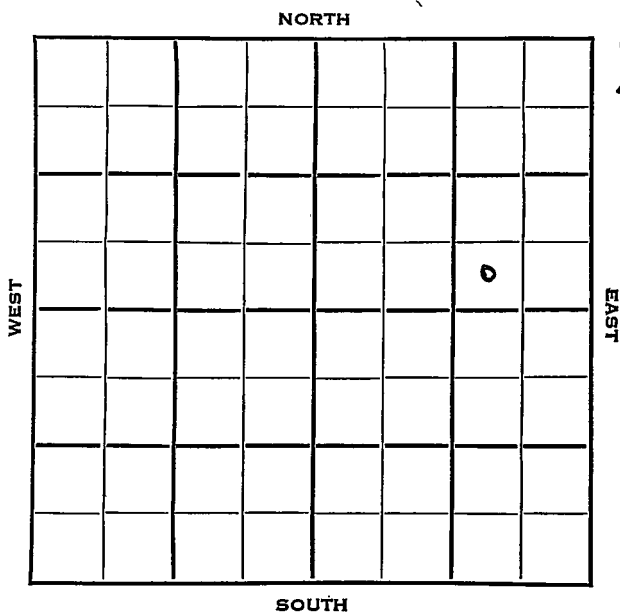


Section 35 Township 9 Range 20WWell No. L Wilson "C"Company Francis Oil & Gas

Rooks KANSAS

SEC.	TWP.	R.
35	9	20 W ✓
WELL NO.		
# 1 Wilson "C"		FARM
COMPANY		

Francis Oil & Gas

CONTRACTOR

Armer

Eagle Creek Pool


_____ Ft. from N. Line

330 _____ Ft. from S. Line

990 _____ Ft. from E. Line

_____ Ft. from W. Line

SW SE NE

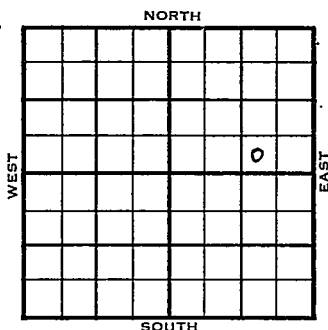

	ELEVATION	REPORT
1954	2250'	
2/24	Spud 2-18-54 8" @ 214' Anhy 1710' Drlg. 1845'	
3/3	Drlg. 3446'	
3/10	NR	
3/24	Heeb 3461 Tor 3479 Lans 3500 Cong. 3758 DST 3520-64, 1 hr, 690' oil & W 1200# DST 3645-87, 1 hr, 180' oil, 600' O & GCM. 1150# RTD 3863 5" @ 3744 48/3678-90	
3/31	S/45 BOPH	
4/28	Spud 2-18-54 Oil Well TD 3863' 8" @ 214' Anhy 1710'; Heeb 3461', Tor 3479', Lans 3500', Cong 3758' DST 3520-64', opn 1 hr., rec. 690' oil, & wtr, 1200# DST 3645-87', opn 1 hr., rec. 180' oil, 600' O&GCM 1500# TD 3863' 5" @ 3744' 48/3678-90, S/45 boph Comp. 130 bopd	
		COMPLETED

J. G. McGEHEE

J. G. McGEHEE