


Section 35 Township 9 Range 20W

Well No. #8 Wilson "C"

Company Francis Oil & Gas

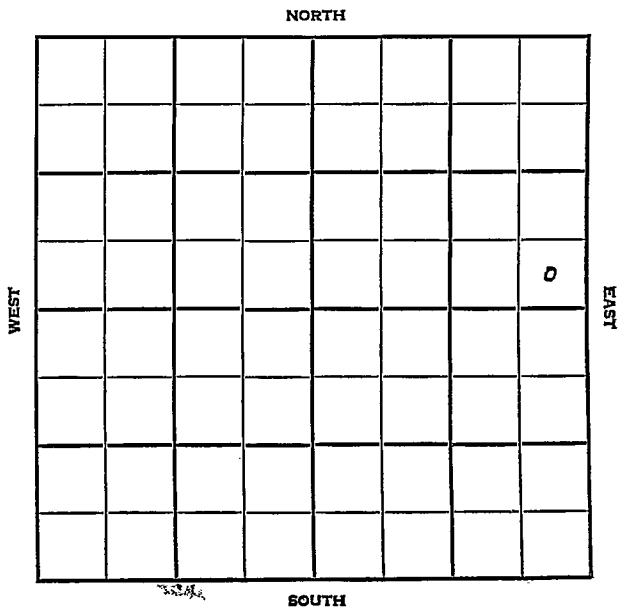





County \_\_\_\_\_ Rooks State **Kansas**  
 Sec. 35 (Blk. Twp.) 9 (Sur. Rge.) 20W Map No. \_\_\_\_\_  
 Operator **Francis Oil & Gas**  
 Well No. 8 Farm **Wilson "C"**  
 Elev. 2253 Location **SE SE NE**


330 Ft. From S Line NE  
 265 Ft. From E Line Quarter  
 Ist. Report \_\_\_\_\_  
 Completion **APR 20 1955**  
 Remarks **Marcotte Pool**  
**K & E Drlg. - Contr.**  
 Spudding Date **2-19-55**

Drlg. Data Oil well TD 3797  
 8" @ 220 Heeb. 3459 Tor. 3479  
 Lans. 3499 DST 3524-64 open 1 hr.  
 Rec. 200' gas 90' hocm DST 3576-91  
 open 1 hr. Rec. 1530' oil 540' sw  
 Arb. 3787 TD 3795 5" @ 3790 CO to  
 3790 DD 3795 FU 120' oil 1½ hr.  
 DST 3640-85 open 1 hr. Rec. 90' socm  
 205' hocm 108' free oil 630#  
 B KC 3708 Cong. 3745 TD 3794 5" @ 3789  
 DD 3797 S/ 22 boph 4 hr.  
 Comp. 3000 bopd

FABEN GILSTRAP