

KANSAS

Graham

Section 35 Township 9 Range 2W

Well No. 1 De Young

Company M.B. Armer

Wildcat
NORTH

			0				

12
11

WEST

EAST

SOUTH

Sec. 35 Twp. 9 R. 21W

Well No. #1 De Young Farm

M. B. Armer Company


Wildcat

330' Ft. from N. Line

_____ Ft. from S. Line

330' Ft. from E. Line

_____ Ft. from W. Line

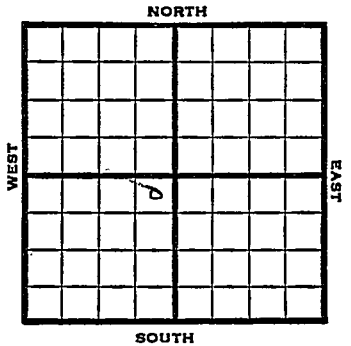

NE SW

1949	Elev 2317' REPORT
------	-------------------

5/25	8" @ 159'
------	-----------

6/1	Drlg. 1770'
-----	-------------

6/8	Lans 3570'
-----	------------

	Drlg 3610'
--	------------

	Cong 3855'
--	------------

	Arb. 3922'
--	------------

	TD 3960'
--	----------

	Aband.
--	--------

ABANDONED

Map No. _____ Sec. 35 Twp. 9 R. 21W

Well No. 1 De Young

M. B. Armer Company

Contractor

NE SW

FIRST REPORT
SECTION PLAT

330 Ft. from N. Line

_____ Ft. from S. Line

330 Ft. from E. Line

_____ Ft. from W. Line

Sheridan County

Location _____

Rig up _____

Drilling and Remarks:

8" @ 159

drlg. 1770

RECORD

Cased _____ in., _____ ft.

Sand _____

Gas _____

Oil _____

Total Depth _____

PRODUCTION

1st 24 hrs. Nat. _____

1st 24 hrs. after shot _____

Gas _____ Cu. Ft.

Dry Hole _____

Abandoned _____

Date

MAY 25 1949

19

S. J. LEWIS

Scout

Map No. _____ Sec. 35 Twp. 9 R. 21W

Well No. 1 De Young

M. B. Armer _____ Company

CORRECTION _____ Contractor

NE SW


SECTION PLAT

330 Ft. from N. Line

_____ Ft. from S. Line

330 Ft. from E. Line

_____ Ft. from W. Line

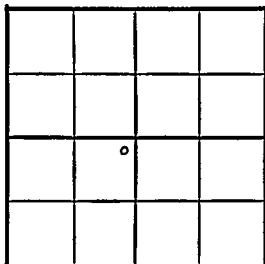

Graham County

Location _____

Rig up _____

Drilling and Remarks:

Reported in
Sheridan County

RECORD

Cased _____ in., _____ ft.

Sand _____

Gas _____

Oil _____

Total Depth _____

PRODUCTION

1st 24 hrs. Nat. _____

1st 24 hrs. after shot _____

Gas _____ Cu. Ft.

Dry Hole _____

Abandoned _____

Date

MAY 25 1949 19

S. J. LEWIS Scout

Graham County Kansas State

Map No. K 65 Sec. 35 Twp. 9 R. 21W

Well No. 1 De Young

M. B. Armer Company

ABANDONED

Contractor

NE SW

E1,2317

SECTION PLAT

330 Ft. from N. Line

 Ft. from S. Line

330 Ft. from E. Line

 Ft. from W. Line

Wildcat

Remarks:

Co. 93855
Co. 83922
Co. 113960

Date
 JUN 8 1949

Scout **S. J. LEWIS**