

Graham

Sec. 35 Twp. 9 R. 21W

Well No. #1 De Young Farm

Aylward Company

Contractor

Cooper


Ft. from N. Line

330 Ft. from S. Line

Ft. from E. Line

330 Ft. from W. Line

SW SW SE

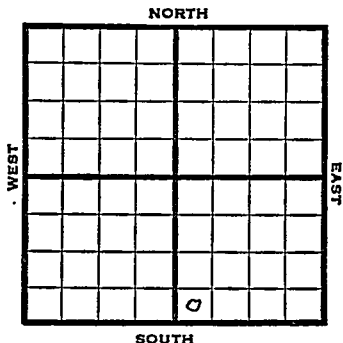

1951 Elev. 2314' REPORT

11/7

RUR

11/21

Spud 11-8-51

D & A TD 3980' 8" @ 110

Anhy 1810' Heeb 3536' Tor. 3561'

Lans. 3579' B KC 3806' Cong. 3905'

Arb. 3950-80' TD

D & A

ABANDONED

