

KANSAS

Section 35 Township 9 Range 21-WWell No. #1 DeYoungCompany C & G Drlg. & Hanson

NORTH

WEST

EAST

Q							

SOUTH

13

Sec. 35 Twp. 9 R. 21-W

Well No. #1 DeYoung Farm

C & G Drlg. & Hanson Company

Contractor

Wildcat


 Ft. from N. Line

330 Ft. from S. Line

 Ft. from E. Line

330 Ft. from W. Line

SW SW SW

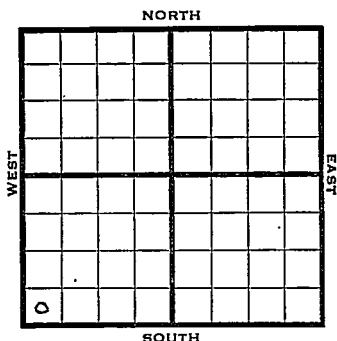

1950

Elev 2273

REPORT

7/12

Location

8/16

8" @ 235

Anhy 1752-87

Top 3265

Heeb 3469

Toronto 3488

Lans 3512

DST 3705-15 opn 35 min rec 20' mud

B KC 3732

Cong 3783

Simp sh 3801

Simp dol 3811

Arb 3823-28 RTD

5" @ 3824 TD 3836 1000 A

S/25 boph FU 2812' oil 12 hr

Comp. Drawn down pot. 3000 bopd

Completed

COMPLETED

Kansas

Wildcat

Map No. _____ Sec. 35 Twp. 9 R. 21WWell No. 1 DeYoungC & G Drlg. & Hanson Company_____
Contractor

SW SW SW

SECTION PLAT

Ft. from N. Line330 Ft. from S. Line_____
Ft. from E. Line330 Ft. from W. LineGraham CountyLocation X

Rig up _____

Drilling and Remarks:

RECORD

Cased _____ in., _____ ft.

Sand _____

Gas _____

Oil _____

Total Depth _____

PRODUCTION:

1st 24 hrs. Nat. _____

1st 24 hrs. after shot _____

Gas _____ Cu. Ft.


Dry Hole _____

Abandoned _____

Date

JUL 12 1950 19 J. E. TYRA Scout

County Graham State Kansas
 Sec. 35 (Blk.) 9 (Sur.) 21W Map No.
 Operator C & G Drlg. & Hanson
 Well No. 1 Farm DeYoung
 Elev. 2273 Location SW SW SW

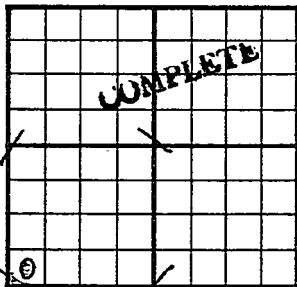

330 Ft. From S Line SW

330 Ft. From W Line Quarter

1st. Report

Completion AUG 1 6 1950

Remarks

Wildcat

Spudding Date

Drlg. Data Oil well TD 3836
8" @ 235 Anhy 1752-87 Top. 3265
Heeb. 3469 Toronto 3488 Lans. 3512
DST 3705-15 open 35 min. Rec. 20' mud
B KC 3732 Cong. 3783 Simp. sh. 3801
Simp. dol. 3811 Arb. 3823-28RTD
5" @ 3824 TD 3836 1000 A
S/ 25 boph FU 2812' oil 12 hr.
Comp. Draw down pot. 3000 bopd

J. E. TYRA