


Section 35 Township 9 Range 21W

Well No. #1 DeYoung

Company K & E Drlg.

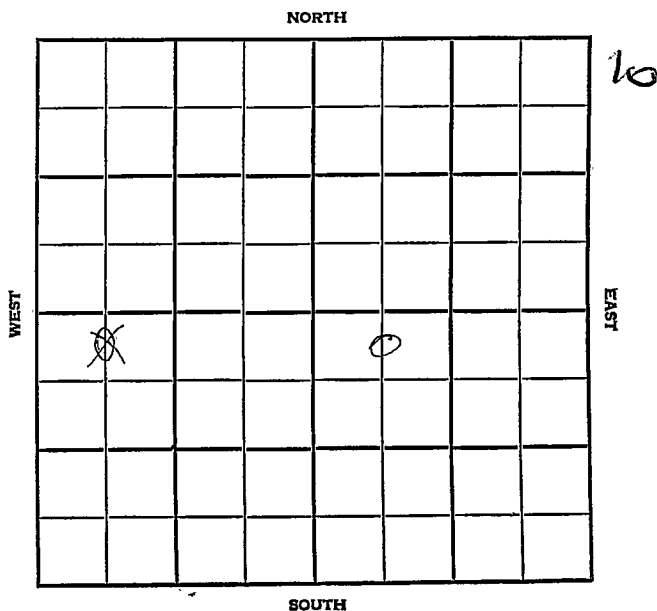

CORRECTION

County Graham Elev. 2312
 Sec. 35 Twp. 19 Rge. 21W
 Company K & E Drilling
 FarmName DeYoung No. 1

TOPS	DEPTH	LOG	DATUM	Loc. in Sec.
Anh.				c N/2 NW 35 SE
Ip.				
H.	3527			
Tr.	3552			
Dg.				
Bl.				
L.	3571			Geol.
K.C.				Contr.
B.K.C.	3796			Co. Tools
Ce.				Pool
C.	3890			Cooper
M.				<div style="border: 2px solid black; padding: 5px; text-align: center;"> ABANDONED NOV 15 '56 </div>
M.				
K.				
Mz.				
Ma.				
V.				
S.				
S.				
A.	3907			
R.				
PE.				
G.				
TD.	3928			

Date Comm.

Location NOV 7 '56 10-31-56 85/8

209/140 MD 3615 NOV 13 '56

DST 3906-15 30" rec 10' Md (USSO)
 750/15"

D&A