


Section 35 Township 9 Range 21W

Well No. #1 DeYoung "A"

Company C & G Drlg.

NORTH

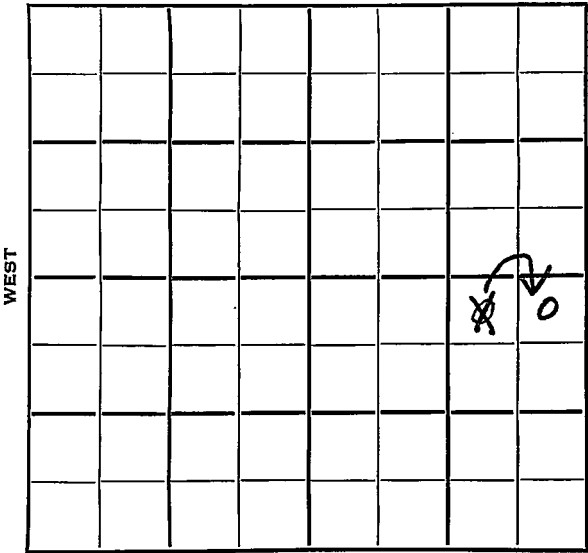

9

WEST

EAST

SOUTH

Sec. 35 Twp. 9 R. 21W

Well No. #1 DeYoung "A" Farm

C & G Drlg. Company

C & G Drlg. Contractor

Cooper Pool


330 Ft. from N. Line

_____ Ft. from S. Line

~~990~~ 330 Ft. from E. Line

_____ Ft. from W. Line

NE NE SE
NW NE SE

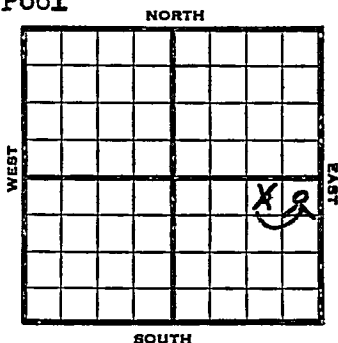

1953 Elev. 2290' REPORT

8/19 C & P'

8/26 8" @ 165' w/90 sks

9/2 Heeb 3528, Tor 3554, Lans 3570
Drlg 3775'

9/9 Spud 8-24-53

D&A

TD 4012'

8" @ 165

Heeb 3528, Tor 3554, Lans 3570,

Cong 3889

TD 4012

D&A

ABANDONED

Map No. _____ Sec. 35 Twp. 9 R. 21W

Well No. 1 DeYoung "A"

C & G Drlg. Company

CORRECTION

Contractor

NE NE SE

SECTION PLAT

330 Ft. from N. Line

_____ Ft. from S. Line

330 Ft. from E. Line

_____ Ft. from W. Line

			0-0

Graham County

Location _____

Rig up _____

Drilling and Remarks:

Reported
NW NE SE

RECORD

Cased _____ in., _____ ft.

Sand _____

Gas _____

Oil _____

Total Depth _____

PRODUCTION

1st 24 hrs. Nat. _____

1st 24 hrs. after shot _____

Gas _____ Cu. Ft.

Dry Hole _____

Abandoned _____

Date

AUG 26 1953₁₉

J. G. McGFLEE Scout

