


Section 35 Township 9 Range 21WWell No. #2 DeYoungCompany C & G Drlg. et al

NORTH

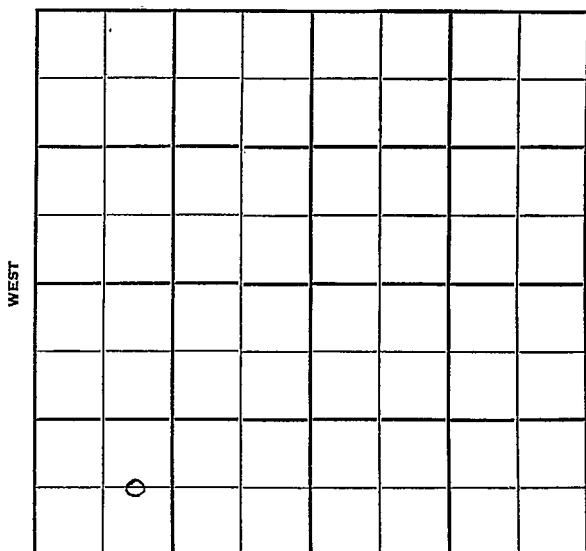

SOUTH

13

Graham

KANSAS

Sec. 35 Twp. 9 R. 21W

Well No. #2 DeYoung Farm

C & G Drlg. et al Company

C & G Drlg. - Contr. Contractor

Cooper Pool


 Ft. from N. Line

660' Ft. from S. Line

 Ft. from E. Line

990' Ft. from W. Line

C E L SW SW

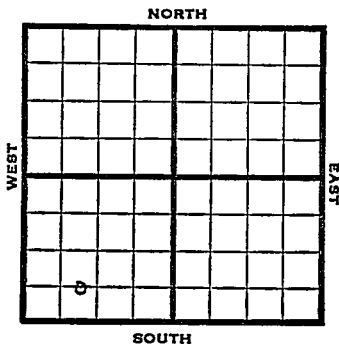

1951 Elev. 2294' REPORT

1/24 Cellar & Pits

3/28 Spud 1-26-51
Oil well TD 3849'
8" @ 230 Anhy 1765', Top 3282',
Heeb. 3489', Toronto 3514', KC 3532'
B KC 3756', Simp. 3828', Arb. 3845',
TD 3848' 5" @ 3846 $\frac{1}{4}$, DD 3849'
FU 2200' oil 500 A
Comp. deptho. pot. 12,718 bopd

COMPLETED

County Graham State Kansas

Sec. 35 (Blk. Twp.) 9 (Sur. Rge.) 21W Map No.

Operator C & G Drilg. etal.

Well No. 2 Farm DeYoung

Elev. Location C E L SW SW

FIRST REPORT

660 Ft. From S Line SW

990 Ft. From W Line Quarter

Ist. Report JAN 24 1951

Completion

Remarks

C & G Drilg. - Contr.

Spudding Date

Drilg. Data Cooper Pool

Cellar & pits

J. E. TYRA

County Graham State KansasSec. 35 (Blk.
Twp.) 9 (Sur.
Rge.) 21W Map No.Operator C & G Drlg. etal.Well No. 2 Farm DeYoungElev. 2294 Location C E L SW SW

660 Ft. From S Line SW990 Ft. From W Line Quarter

1st. Report

Completion MAR 28 1951Remarks Cooper PoolC & G Drlg. - Contr.Spudding Date 1-26-51Drlg. Data Oil well TD 38498" @ 230 Anhy 1765 Top. 3282Heeb. 3489 Toronto 3514 KC 3532B KC 3756 Simp. 3828 Arb. 3845TD 3848 5" @ 3846 $\frac{1}{4}$ DD 3849 FU 2200'oil 500 A Comp. deptho. pot. 12,718 bop

J. E. TYRA